47600

IREDELL COUNTY HEALTH DEPARTMENT

STATESVILLE 704-878-5305 MOORESVILLE 704-664-5281

IMPROVEMENT PERMIT / CERTIFICATE OF COMPLETION / OPERATION PERMIT / EXISTING SYSTEM INSPECTION

PROPERTY DESCRIPTION NO. 16443 DATE 6-15-93 TAX MAP NO. 10 H-1-A-6

OWNER OR CONTRACTOR Allen Nicholson PHONE: Business 876-0861 Home 876-0862

ADDRESS 170 Dunlap ~~Gate~~ circle Statesville

LOCATION US 21 N TR Dunlap Gate Rd TL Dunlap Gate Loop 4th Hse on left

SUBDIVISION Dunlap Gate BLOCK / SECTION LOT 6 LOT AREA SITE CLASS. P.S. L.T.A.R. .4

Water Supply: ☐ Individual ☐ Community ☒ Public

Septic Tank: Ex. Gallons; STB Date

Pump Tank: Gallons; PT Date

Nitrification Field: No Fields 2 Square Feet ~~360~~ 140 Linear Feet ~~120~~

No Lines 2 ~~3~~ Trench Width 36 Trench Depth 24 Gravel Depth 12+

☐ New System ☒ Repair System Type: I, II, III, IV, V, VI

System Description:

Repair System Description: Adding 2 lines

Maintenance Agreement Required: ☐ Yes ☒ No

☐ House/Mod. Home No. Bedrooms Garbage Disposal: ☐ Yes ☐ No

☐ Mobile Home No. Bathrooms Auto. Dishwasher: ☐ Yes ☐ No


☐ Business No. Employees Auto. Washing Machine: ☐ Yes ☐ No

☐ Other Other


☐ Slab ☐ Crawl Space ☐ Basement w/plumbing ☐ Basement wo/plumbing

Comments Adding storage building over part of Drain lines Adding back over lower portion of lot

INITIAL SITE SKETCH

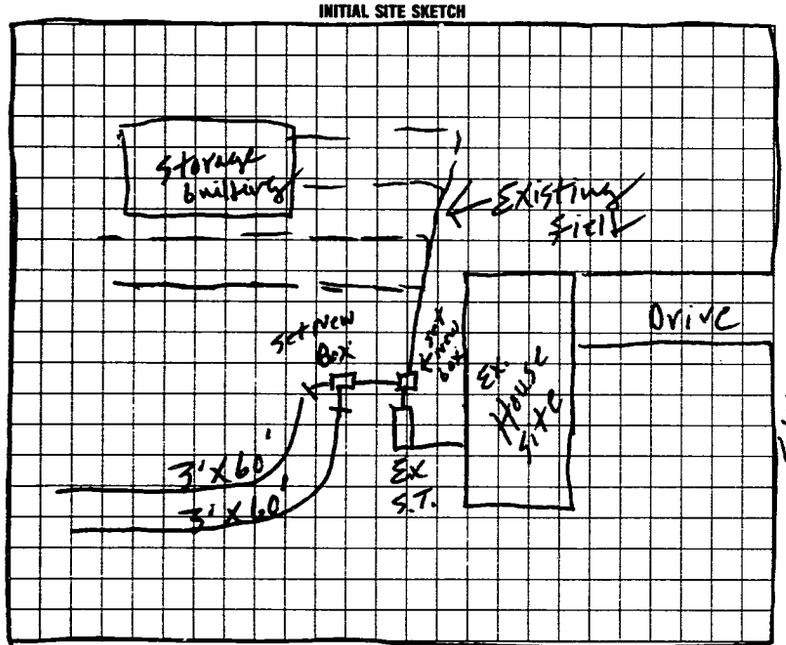

AS BUILT SKETCH

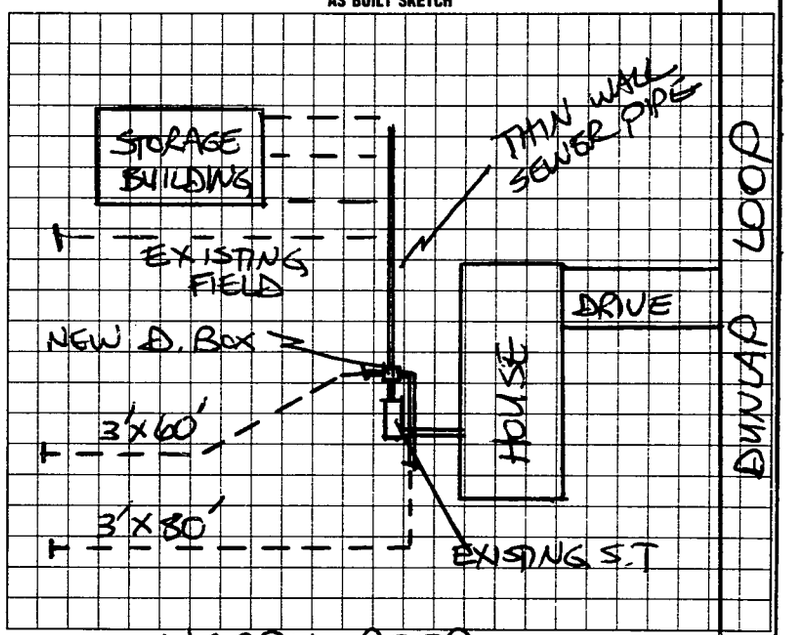

I understand that this permit can be suspended or revoked if any false information is supplied toward securing the permit/any unauthorized changes are made to the site/any unauthorized changes are made in the installation of the system. Improvement Permit is valid for 60 months from date of issuance.

Signed: x Rhonda Nicholson

Improvement Permit by: L.C. Moore date 6-15-93

Existing System Inspection by: date

Installed by: MARC REED MUSTANG ENTERPRISES

Certificate of Completion by: STEVE HENDRICK / MIKE DENNIS date 7/27/93

Operation Permit by: date

HEALTH DEPT. COPY: WHITE INSPECTION COPY (FINAL): GREEN OWNER COPY (FINAL): YELLOW INSPECTION COPY (INITIAL): PINK OWNER COPY (INITIAL): GOLD