IREDELL COUNTY HEALTH DEPARTMENT

STATESVILLE 704-878-5305 MOORESVILLE 704-664-5281

IMPROVEMENT PERMIT / CERTIFICATE OF COMPLETION / OPERATION PERMIT / EXISTING SYSTEM INSPECTION

PROPERTY DESCRIPTION NO. Repair DATE 1-18-95 TAX MAP NO.

OWNER OR CONTRACTOR Bill Martin PHONE: Business Home 876-2764 Watershed: ☐ Yes ☐ No

ADDRESS 154 Tunnersburg Hwy

LOCATION 21 N on left just before G W Furniture

SUBDIVISION BLOCK / SECTION LOT LOT AREA 2 acres SITE CLASS. PS DESIGN FLOW L.T.A.R. .3

Septic Tank: Ex. Gallons; STB Date

Pump Tank: Gallons; PT Date

Pump Make: Model 1720 Serial No.

Nitrification Field: No Fields 2 Square Feet [illegible] Linear Feet 240

No Lines 3 Trench Width 36" Max Trench Bottom Depth 36" Gravel Depth 12"

☐ New System ☑ Repair System Type: I, II, III, IV, V, VI

System Description:

Repair System Description: Conv. Capacity

Maintenance Agreement Required: ☐ Yes ☑ No

☐ Slab ☐ Crawl Space ☐ Basement w/plumbing ☐ Basement wo/plumbing

☑ House/Mod. Home No. Bedrooms 3

☐ Mobile Home No. Bathrooms

☐ Business No. Employees


☐ Other

Water Supply: ☐ Individual ☐ Community ☑ Public


Comments:

Comments: 754 to 24" Stone

INITIAL SITE SKETCH

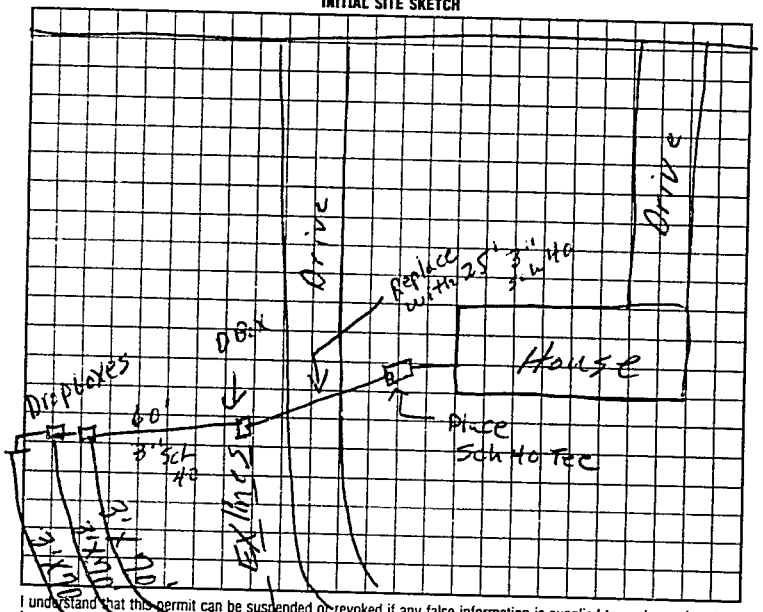

AS BUILT SKETCH

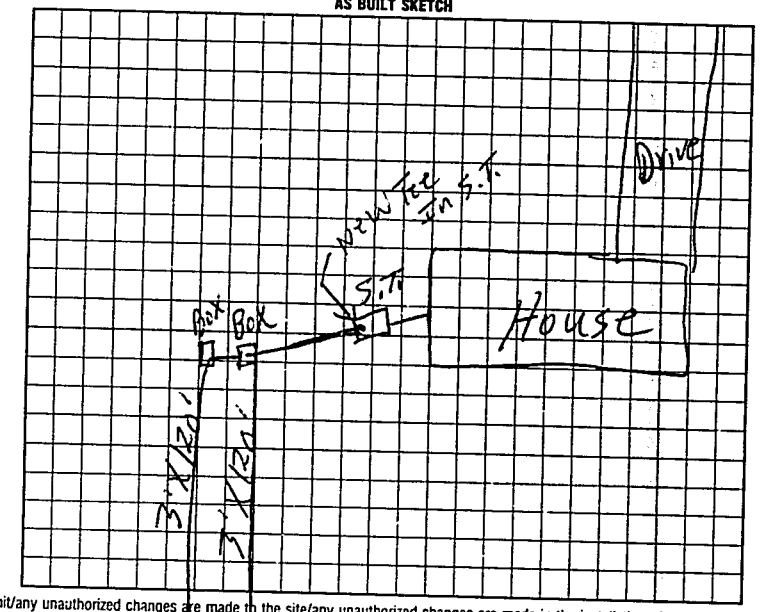

I understand that this permit can be suspended or revoked if any false information is supplied toward securing the permit/any unauthorized changes are made to the site/any unauthorized changes are made in the installation of the system. Improvement Permit is valid for 60 months from date of issuance.

Signed: x William S. Martin

Improvement Permit by: R. C. Moore date 1-18-95

Existing System Inspection by: date

Installed by: Tommy Frye

Certificate of Completion by: R. C. Moore date 1-25-95

Operation Permit by: date

HEALTH DEPT. COPY: WHITE INSPECTION COPY (FINAL): GREEN OWNER COPY (FINAL): YELLOW INSPECTION COPY (INITIAL): PINK OWNER COPY (INITIAL): GOLD

0 0 1 3 2 0