Permit #170211 attached for porch addition 1-5-12.

IREDELL COUNTY HEALTH DEPARTMENT - ENVIRONMENTAL HEALTH ☐ STATESVILLE OFFICE 704-878-5305 ☐ MOORESVILLE OFFICE 704-664-5281

IMPROVEMENT PERMIT / AUTHORIZATION TO CONSTRUCT / OPERATION PERMIT / EXISTING SYSTEM INSPECTION

PERMIT # Repair PIN # 4757-88-3801 DATE 18 August 2011

OWNER Nathaniel Snow APPLICANT: PHONE: Home/Cell # (704) 818-7668 Business #

SITE ADDRESS 1571 Turnersburg Hwy Stvl. OWNER / APPLICANT ADDRESS

SITE DIRECTIONS Hwy 21 N Th Big Cedar Dr. - on Rt. 0.87 ac

SUBDIVISION BLOCK / SECTION LOT # LOT AREA DESIGN FLOW 240 gpd L.T.A.R. exist

Septic Tank 1000 Gallons: STB 1600 Date 4-25-12 ☐ New System ☑ Repair ☐ Expansion System Type I (II) III IV V VI

Pump Tank Gallons: P T Date System Description: Conventional / gravity

Pump Make Model Serial # Repair System Description: Tank

No. Nitrification Fields: Ex No. Lines Ex Linear Feet Ex Maintenance Agreement Required ☐ YES ☑ NO

Trench Width Ex Max. Trench Bottom Depth Ex Gravel Depth Ex ☑ GRAVITY ☐ PRESSURE

☑ Residence No. Bedrooms 2 ☐ Business No. Persons ☐ Other No. Employees ☐ Slab ☐ Crawl Space ☐ Basement w/plumbing ☑ Basement w/o plumbing


Water Supply: ☐ Private ☑ Public ☐ Community

Comments / Conditions * Washing machine shall be plumbed into Septic system


* Keep 15' from basement.

Polylok Filter / ST Marker

INITIAL SITE SKETCH

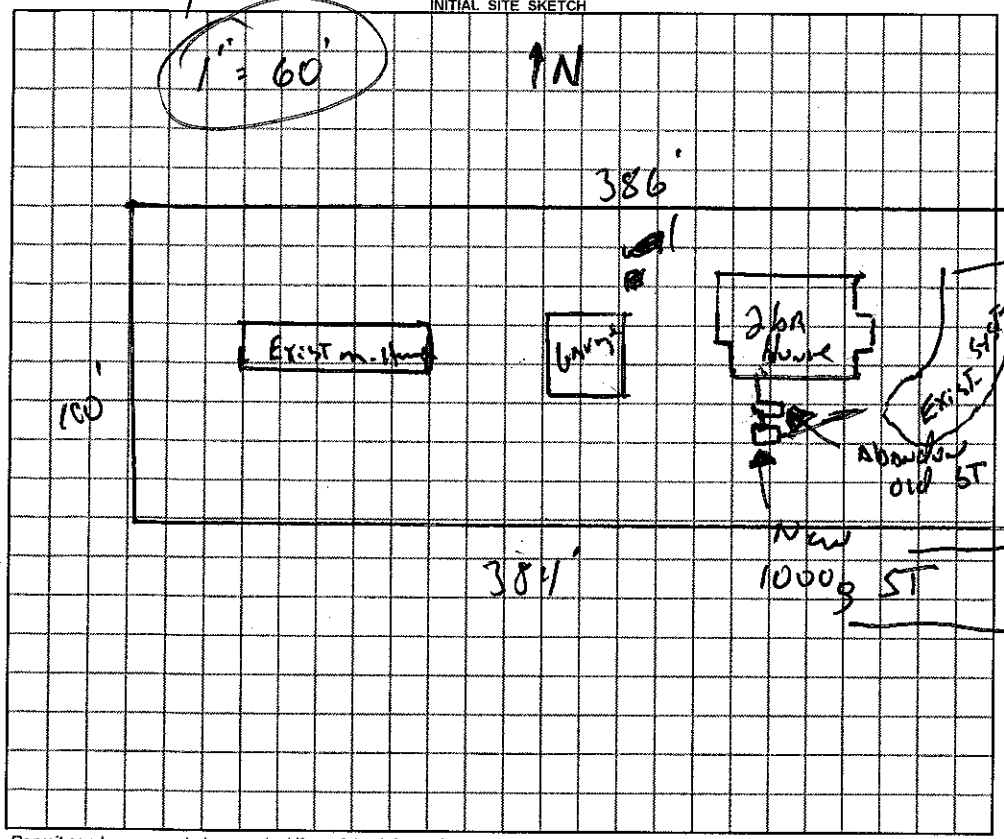

AS BUILT SKETCH

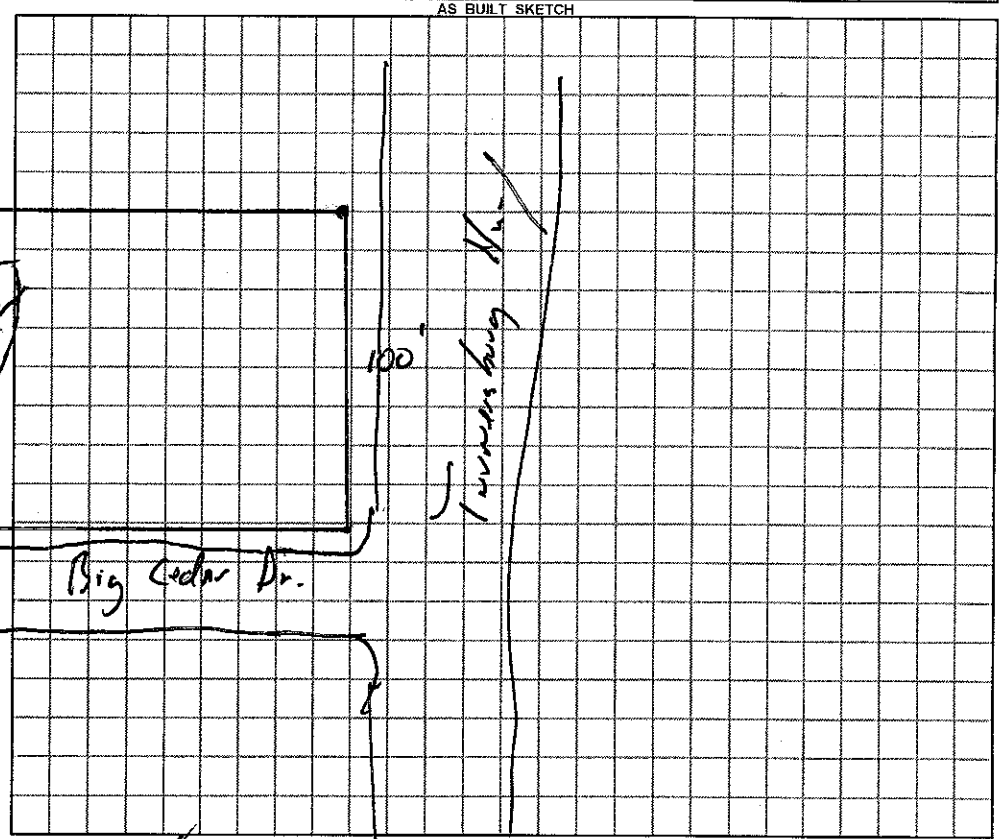

Permit can be suspended or revoked if any false information is supplied toward securing the permit / any unauthorized changes are made to the site / any unauthorized changes are made in the installation of the system.

☐ ***IMPROVEMENT PERMIT*** *with plat valid without expiration.* ☐ ***IMPROVEMENT PERMIT*** *with ~~plat valid without expiration.~~ site plan valid 60 mo.* ☑ ***AUTHORIZATION TO CONSTRUCT*** valid for period equal to IMPROVEMENT PERMIT--not to exceed 60 mo.

Owner / Applicant Signature: Nathaniel Snow Date

IMPROVEMENT PERMIT by: REHS Date

AUTHORIZATION TO CONSTRUCT by: REHS Date 18 Aug. 11

YOU SHOULD CONTACT A LOCATOR SERVICE PRIOR TO ANY EXCAVATION

Installed by: K + M Grading

OPERATION PERMIT by: REHS Date 25 Aug. 11

Existing System Inspected by: REHS Date

White Copy – Environmental Health YELLOW COPY (Final) Owner / Applicant PINK COPY (Initial) Owner / Applicant