IREDELL COUNTY HEALTH DEPARTMENT - *ENVIRONMENTAL HEALTH* ☐ STATESVILLE OFFICE 704-878-5305 ☐ MOORESVILLE OFFICE 704-664-5281

IMPROVEMENT PERMIT / AUTHORIZATION TO CONSTRUCT / OPERATION PERMIT / EXISTING SYSTEM INSPECTION

PERMIT # REPAIR PIN # 4757-88-3801 DATE 18 August 2011

OWNER Nathaniel Snow APPLICANT: PHONE: Home/Cell # (704) 818-7668 Business #

SITE ADDRESS 1571 Turnersburg Hwy Stat. OWNER / APPLICANT ADDRESS

SITE DIRECTIONS Hwy 21 N TL Big Cedar Dr. - on Rt. 0.87 AC

SUBDIVISION BLOCK / SECTION LOT # LOT AREA DESIGN FLOW 240 g/d L.T.A.R. exist.

Septic Tank 1000 Gallons: STB 160 Date 4-25-11 ☐ New System ☑ Repair ☐ Expansion System Type I (II) III IV V VI ☑ Residence No. Bedrooms 2 Water Supply

Pump Tank Gallons: P T Date ☐ Business No. Persons ☐ Private

Pump Make Model Serial # ☐ Other No. Employees ☑ Public

No. Nitrification Fields: Ex No. Lines Ex Linear Feet Ex System Description: Conventional gravity ☐ Slab ☐ Crawl Space ☐ Community

Trench Width Ex Max. Trench Bottom Depth Ex Gravel Depth Ex Repair System Description: T and L ☐ Basement w/plumbing ☑ Basement w/o plumbing

Maintenance Agreement Required ☐ YES ☑ NO


☑ GRAVITY ☐ PRESSURE

Comments / Conditions * Washing machine shall be plumbed into Sept. c system.


* Keep 15' from basement.

Poly/Ink Filter / ST MARKER

INITIAL SITE SKETCH

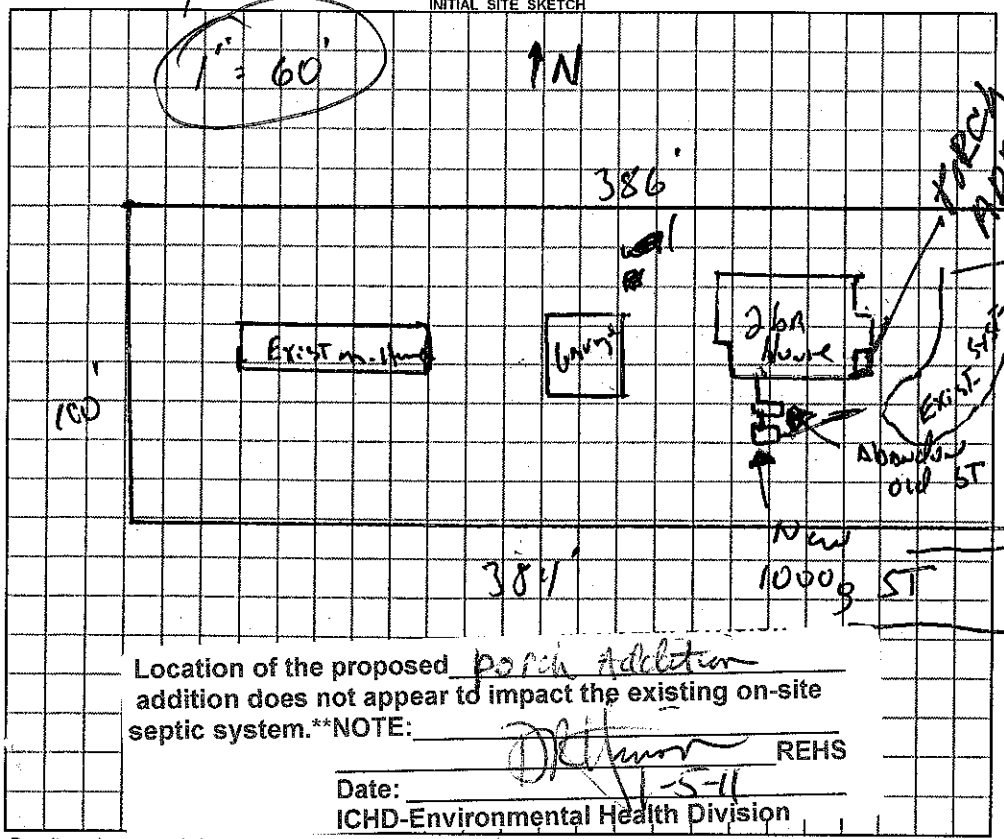

AS BUILT SKETCH

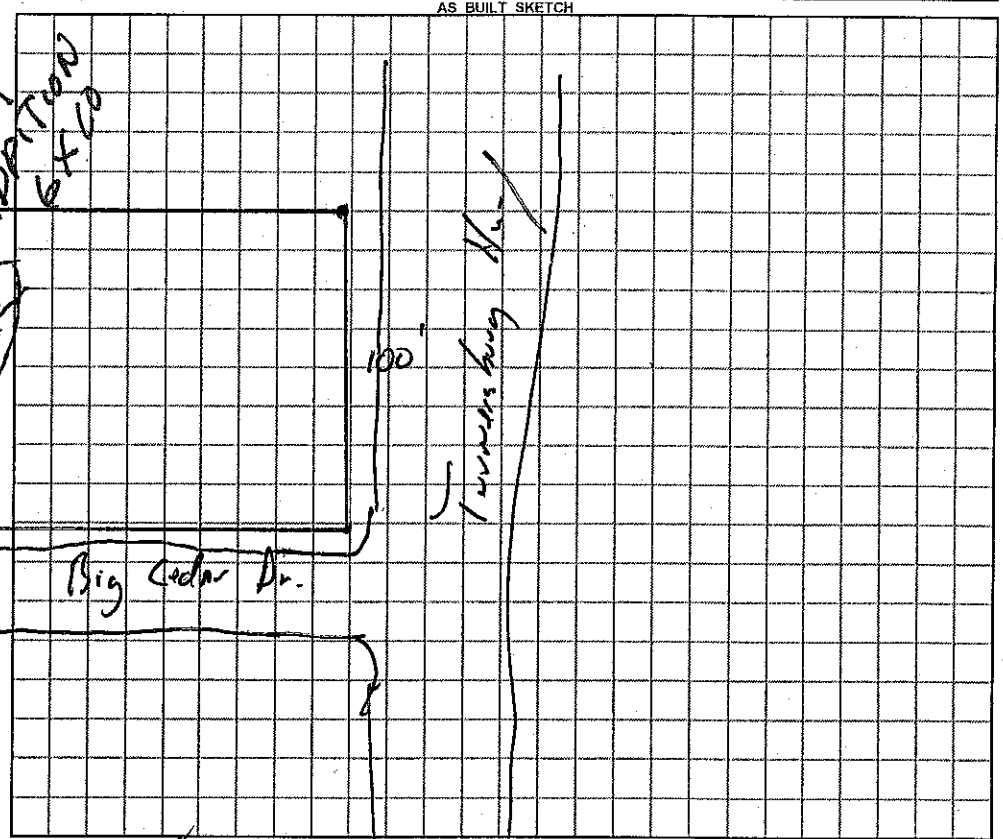

Location of the proposed porch Addition addition does not appear to impact the existing on-site septic system.**NOTE:

REHS

Date: 4-5-11

ICHD-Environmental Health Division

Permit can be suspended or revoked if any false information is supplied toward securing the permit / any unauthorized changes are made to the site / any unauthorized changes are made in the installation of the system.

☐ *IMPROVEMENT PERMIT* with plat valid without expiration. ☐ *IMPROVEMENT PERMIT* with ~~plat valid without expiration.~~ *site plan valid 60 mo.* ☑ *AUTHORIZATION TO CONSTRUCT* valid for period equal to IMPROVEMENT PERMIT--not to exceed 60 mo.

Owner / Applicant Signature: Nathaniel Snow Date

IMPROVEMENT PERMIT by: REHS Date

AUTHORIZATION TO CONSTRUCT by: REHS Date 18 Aug. 11

Installed by: K & M Grading

OPERATION PERMIT by: REHS Date 25 Aug. 11

Existing System Inspected by: REHS Date

YOU SHOULD CONTACT A LOCATOR SERVICE PRIOR TO ANY EXCAVATION

White Copy – Environmental Health YELLOW COPY (Final) Owner / Applicant PINK COPY (Initial) Owner / Applicant