IREDELL COUNTY HEALTH DEPARTMENT

STATESVILLE 704-878-5305 MOORESVILLE 704-664-5281

IMPROVEMENT PERMIT / AUTHORIZATION TO CONSTRUCT / OPERATION PERMIT / EXISTING SYSTEM INSPECTION

PERMIT# _____ PIN# _____ DATE 4-1-99

OWNER OR CONTRACTOR Forest mitchell PHONE: Business _____ Home 876-1199

ADDRESS 1550 Turnersburg Hwy

LOCATION 21 N on Rt Before Blackwelder Rd across from GTW Furniture

SUBDIVISION _____ BLOCK / SECTION _____ LOT _____ LOT AREA acreage SITE CLASS _____ DESIGN FLOW _____ L.T.A.R. _____

Septic Tank: 1000 Gallons; STB 1012 Date 1-17-99 ☐ New System ☑ Repair System Type: I, II, III, IV, V, VI

Pump Tank: _____ Gallons; PT _____ Date _____ System Description: _____

Pump Make: _____ Model _____ Serial No. _____ Repair System Description: _____

Nitrification Field: No Fields ____ Square Feet _____ Linear Feet _____ Maintenance Agreement Required: ☐ Yes ☐ No

No Lines _____ Trench Width _____ Max Trench Bottom Depth _____ Gravel Depth _____ ☐ Slab ☐ Crawl Space ☐ Basement w/plumbing ☐ Basement wo/plumbing

☐ House/Mod. Home No. Bedrooms ____

☐ Mobile Home No. Bathrooms ____

☐ Business No. Employees ____


☐ Other _____

Water Supply: ☐ Individual ☐ Public ☐ Community

Comments/Conditions: Replace Broken S.T.

Comments/Conditions

INITIAL SITE SKETCH

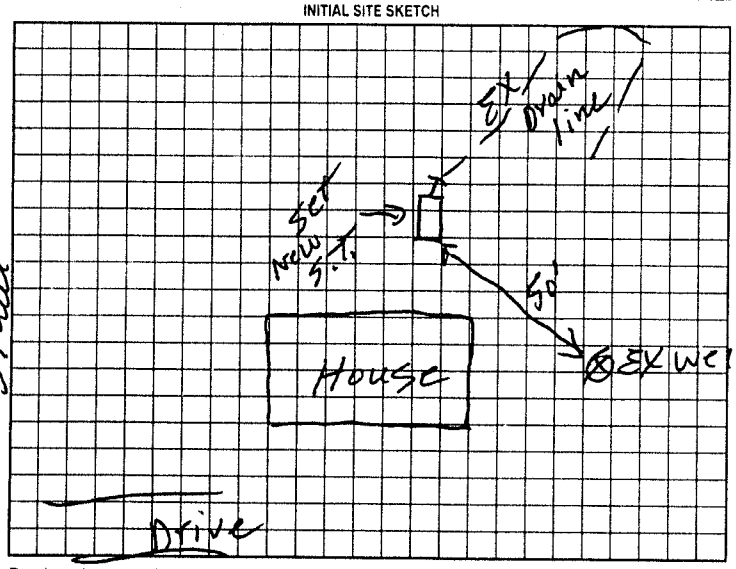

Stuart

AS BUILT SKETCH

Same as initial sketch

Permit can be suspended or revoked if any false information is supplied toward securing the permit/any unauthorized changes are made to the site/any unauthorized changes are made in the installation of the system. Improvement Permit with plat valid without expiration. Improvement Permit with site plan valid for sixty months. Authorization to Construct is valid for a period equal to that of Improvement Permit – not to exceed sixty months.

Signed: X _____ date _____ Installed by: A-1 Backhoe

Improvement Permit by: P. C. Moore date 4-1-99 Operation Permit by: P. C. Moore date 4-1-99

Authorization to Construct by: P. C. Moore date 4-1-99 Existing System Inspection by: _____ date _____

HEALTH DEPT COPY: WHITE OWNER COPY (FINAL): YELLOW OWNER COPY (INITIAL): PINK