IREDELL COUNTY HEALTH DEPARTMENT

STATESVILLE 704-878-5305 MOORESVILLE 704-664-5281

IMPROVEMENT PERMIT / AUTHORIZATION TO CONSTRUCT / OPERATION PERMIT / EXISTING SYSTEM INSPECTION

PERMIT# 089450 PIN# 4757893551 DATE June 1, 2000

OWNER OR CONTRACTOR Debra Patton PHONE: Business 838-1048 Home

ADDRESS 120 Dairy Ln. Stat.

LOCATION 21 N 1 1/2 1/2 miles North of Stat/Auto Auction on left just before/next to #1607 Turnersburg Hwy

SUBDIVISION BLOCK / SECTION LOT LOT AREA 100'X215' SITE CLASS PS DESIGN FLOW 360gpd L.T.A.R. .83

Septic Tank: 1000 Gallons; STB 1012 Date 2-2-00
Pump Tank: Gallons; PT Date
Pump Make: Model Serial No.
Nitrification Field: No Fields 1 Square Feet 1200 Linear Feet 400
No Lines 4@100' Trench Width 36" Max Trench Bottom Depth 36" Gravel Depth 12"

☑ New System ☐ Repair System Type: I II III IV V VI
System Description: Gravity Conventional
Repair System Description: Innovative +25% Red.
Maintenance Agreement Required: ☐ Yes ☑ No

☐ House/Mod. Home No. Bedrooms 3
☑ Mobile Home DW No. Bathrooms 2
☐ Business No. Employees
☐ Other
☐ Slab ☑ Crawl Space ☐ Basement w/plumbing ☐ Basement wo/plumbing


Water Supply: ☐ Individual ☑ Public ☐ Community

Comments/Conditions:

Comments/Conditions:

1" = 100'

INITIAL SITE SKETCH

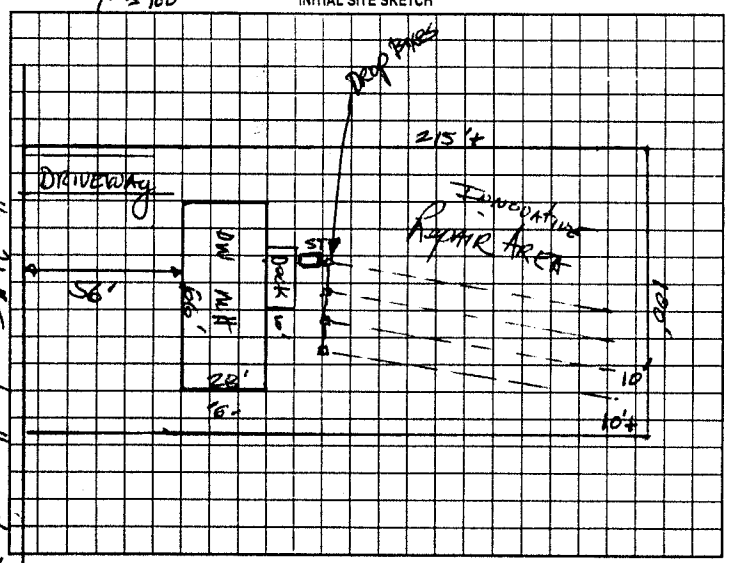

AS BUILT SKETCH

System installed as designed
Two D. Boxes feeding Lines 1 & 2 And 3 & 4

Permit can be suspended or revoked if any false information is supplied toward securing the permit/any unauthorized changes are made to the site/any unauthorized changes are made in the installation of the system. Improvement Permit with plat valid without expiration. Improvement Permit with site plan valid for sixty months. Authorization to Construct is valid for a period equal to that of Improvement Permit – not to exceed sixty months.

Signed: Debra Patton date

Improvement Permit by: date 6-1-00

Authorization to Construct by: date 6-1-00

Installed by: Tommy Frye / C Thompson

Operation Permit by: date June 9 2000

Existing System Inspection by: date

HEALTH DEPT. COPY: WHITE OWNER COPY (FINAL): YELLOW OWNER COPY (INITIAL): PINK