704 902-4607

IREDELL COUNTY HEALTH DEPARTMENT

STATESVILLE 704-878-5305 MOORESVILLE 704-664-5281

IMPROVEMENT PERMIT / AUTHORIZATION TO CONSTRUCT / OPERATION PERMIT / EXISTING SYSTEM INSPECTION

DATE 6-4-01

PERMIT# 100199 PIN# 4757965938

OWNER OR CONTRACTOR PETREE / STYRON BLDRS PHONE: Business 704-873-5367 Home 704-902-4607

ADDRESS 605 GREEN BERRY DR, STATESVILLE, NC 28625

LOCATION HWY 21N, R DUNLAP GATE, L 2nd DUNLAP LOOP, ON RT IN FIRST CURVE

SUBDIVISION DUNLAP GATE BLOCK/SECTION ____ LOT 16 LOT AREA .5 AC SITE CLASS PS DESIGN FLOW 360 L.T.A.R. .3

Septic Tank: 1000 Gallons: STB 1013 Date [redacted] 7-27-01

Pump Tank: 1000 Gallons: PT P T I 7 Date 9-7-01

Pump Make: GOULDS Model WS 05 11 B Serial No H0174803

Nitrification Field: No Fields 1 Square Feet EQ to 1200' Linear Feet 200'

No Lines 4 Trench Width 24" Max Trench Bottom Depth 36"

[X] New System [ ] Repair System Type: I, II, (III), IV, V, VI

System Description: PUMP PANEL

Repair System Description: LP PANEL

Maintenance Agreement Required: [ ] Yes [X] No

[X] House/Mod. Home No. Bedrooms 3

[ ] Mobile Home No. Bathrooms 2

[ ] Business No. Employees ____

[ ] Other ____


Gravel Depth N/A [ ] Slab [X] Crawl Space [ ] Basement w/plumbing [ ] Basement wo/plumbing

Water Supply: [ ] Individual [X] Public [ ] Community

Comments/Conditions: (1) HOUSE NEEDS TO BE 55' OFF FRONT PROPERTY LINE (2) GULLY MUST BE FILLED BEFORE OP SIGNED (3) MAINTAIN SETBACKS (4) KEEP H2O LINE 10' FROM SYSTEM (5) INSTALL LINES ON CONTOURS

Comments/Conditions: (6) After clearing, call 928-2030 for pump sizing. (7) Use 11 panels in each trench totaling 44 PANELS. Pac Vue Filter & Marker LINES & TANKS CHECKED 10-11-01 NEEDS PRESSURE SET TO ELECTRICAL

INITIAL SITE SKETCH 1"=40'

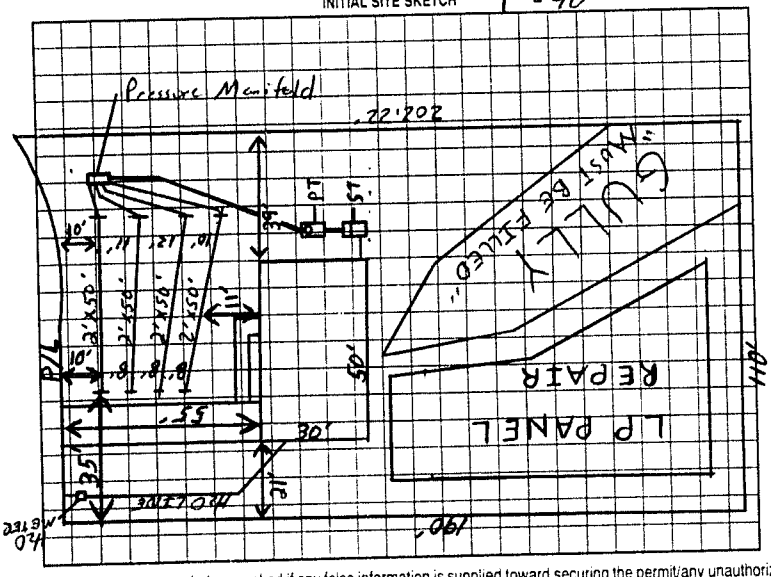

AS BUILT SKETCH

INSTALLED AS SHOWN
PRESSURE SET ON 10-12-01
NEEDS ELECTRICAL CHECKED
(6) ID ALARM SWITCH IN BOX
(5) RISER 6" ABOVE GRADE
(3) SEAL CONDUIT IN METER CAN BOX

SYSTEM INSTALLED ACCORDING TO INITIAL SITE SKETCH

Permit can be suspended or revoked if any false information is supplied toward securing the permit/any unauthorized changes are made to the site/any unauthorized changes are made in the installation of the system. Improvement Permit with plat valid without expiration. Improvement Permit with site plan valid for sixty months. Authorization to Construct is valid for a period equal to that of Improvement Permit – not to exceed sixty months.

Signed: [signature] date 6/27/01 Installed by: PIEDMONT BACKHOE

Improvement Permit by: [signature] RSI date 6-4-01 Operation Permit by: STEVE HEDRICK date 10-24-01

Authorization to Construct by: [signature] RSI date 6-4-01 Existing System Inspection by: ____ date ____

HEALTH DEPT COPY WHITE OWNER COPY (FINAL) YELLOW OWNER COPY (INITIAL) PINK