IREDELL COUNTY HEALTH DEPARTMENT

STATESVILLE 704-878-5305 MOORESVILLE 704-664-5281

IMPROVEMENT PERMIT / AUTHORIZATION TO CONSTRUCT / OPERATION PERMIT / EXISTING SYSTEM INSPECTION

PERMIT# ✓ PIN# 4758-00-0421 DATE 7-12-03

OWNER OR CONTRACTOR TERRY KENNEDY PHONE: Business Home 704-876-3248

ADDRESS 605 BLACKWELDER RD STATESVILLE NC 28625

LOCATION 21 NORTH, (L) JENNINGS, (R) BLACKWELDER (R) BOX # 605


SUBDIVISION BLOCK / SECTION LOT LOT AREA 1.96 AC SITE CLASS. DESIGN FLOW 360 L.T.A.R. EXISTING

Septic Tank: EXISTING Gallons; STB Date	☐ New System ☒ Repair System Type: I, II, III, IV, V, VI	☐ House/Mod. Home No. Bedrooms 3	Water Supply:
Pump Tank: Gallons; PT Date	System Description: GRAV CONV	☒ Mobile Home P/W No. Bathrooms 2	☐ Individual
Pump Make: Model Serial No.	Repair System Description:	☐ Business No. Employees	☒ Public
Nitrification Field: No Fields ✓ Square Feet ✓ Linear Feet ✓	Maintenance Agreement Required: ☐ Yes ☒ No	☐ Other	☐ Community
No Lines ✓ Trench Width ✓ Max Trench Bottom Depth ✓ Gravel Depth ✓	☐ Slab ☒ Crawl Space ☐ Basement w/plumbing ☐ Basement wo/plumbing		

Comments:/Conditions: (1) SUPPLY LINE OUT OF TANK IS CRUSHED & STOPPED UP. INSTALL NEW TEE, SUPPLY LINE & DIST. BOX TO EXISTING BED AS DRAWN

Comments:/Conditions: (2) THIS PERMIT SERVES AS NOTICE OF VIOLATION & MUST BE REPAIRED IN 30 DAYS.

INITIAL SITE SKETCH

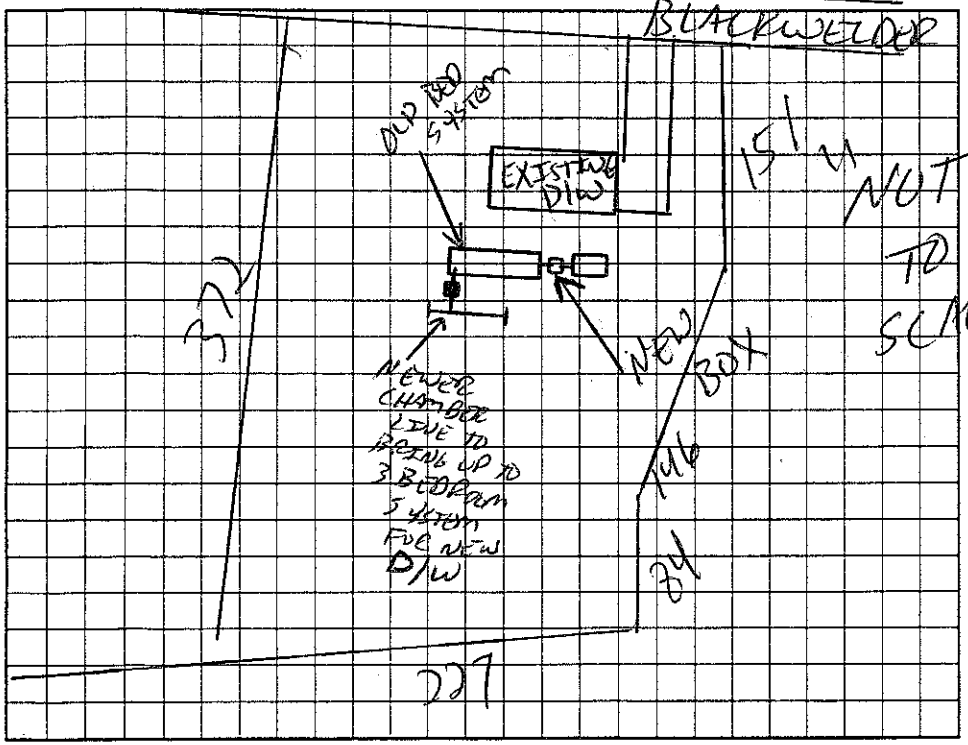

AS BUILT SKETCH

Permit can be suspended or revoked if any false information is supplied toward securing the permit/any unauthorized changes are made to the site/any unauthorized changes are made in the installation of the system. Improvement Permit with plat valid without expiration. Improvement Permit with site plan valid for sixty months. Authorization to Construct is valid for a period equal to that of Improvement Permit – not to exceed sixty months.

Signed: Terry Kennedy date 7-12-03 Installed by: TONY TEAGUE

Improvement Permit by: date 7-12-03 Operation Permit by: date 7-12-03

Authorization to Construct by: date 7-12-03 Existing System Inspection by: date

HEALTH DEPT. COPY: WHITE OWNER COPY (FINAL): YELLOW OWNER COPY (INITIAL): PINK