IREDELL COUNTY HEALTH DEPARTMENT

STATESVILLE 704-878-5305 MOORESVILLE 704-664-5281

IMPROVEMENT PERMIT / AUTHORIZATION TO CONSTRUCT / OPERATION PERMIT / EXISTING SYSTEM INSPECTION

PERMIT# _____ PIN# _____ DATE 11-8-99

OWNER OR CONTRACTOR Daire Shupe PHONE: Business _____ Home 876-1284

ADDRESS 593 Blackwelder Rd

LOCATION US 21 N TL Jennings Rd TR Blackwelder 1 mi on Rt

SUBDIVISION _____ BLOCK / SECTION _____ LOT _____ LOT AREA average SITE CLASS PS DESIGN FLOW 360 L.T.A.R. .35

Septic Tank: 5X. Gallons; STB _____ Date _____

Pump Tank: _____ Gallons; PT _____ Date _____

Pump Make: _____ Model _____ Serial No. _____

Nitrification Field: No Fields 2 Square Feet 900 Linear Feet 300

No Lines 4 Trench Width 36" Max Trench Bottom Depth 36" Gravel Depth 12"

☐ New System ☐ Repair System Type: I, II, III, IV, V, VI

System Description: _____

Repair System Description: Conv. Gravity

Maintenance Agreement Required: ☐ Yes ☐ No

☐ Slab ☐ Crawl Space ☐ Basement w/plumbing ☐ Basement wo/plumbing

☐ House/Mod. Home No. Bedrooms 3

☐ Mobile Home No. Bathrooms 2

☐ Business No. Employees _____

☐ Other _____

Water Supply: ☐ Individual ☐ Public ☐ Community


Comments:/Conditions:

Blackwelter Rd


Comments:/Conditions:

New lines are on Number 2 on Valve

INITIAL SITE SKETCH

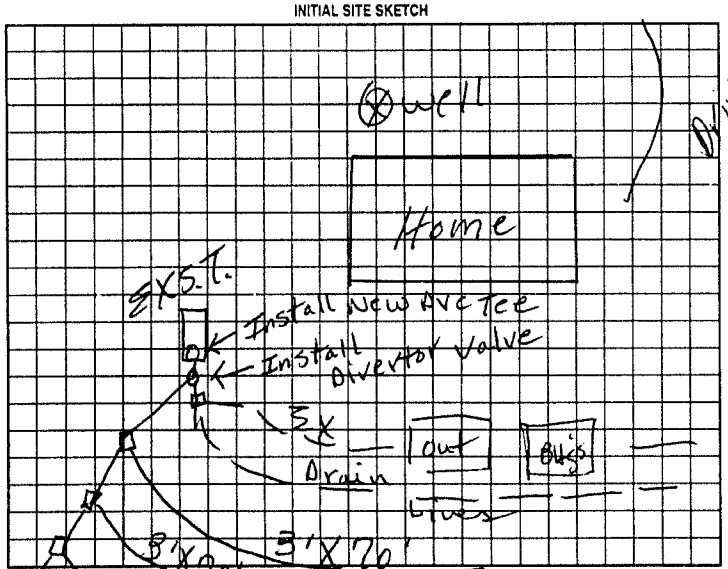

AS BUILT SKETCH

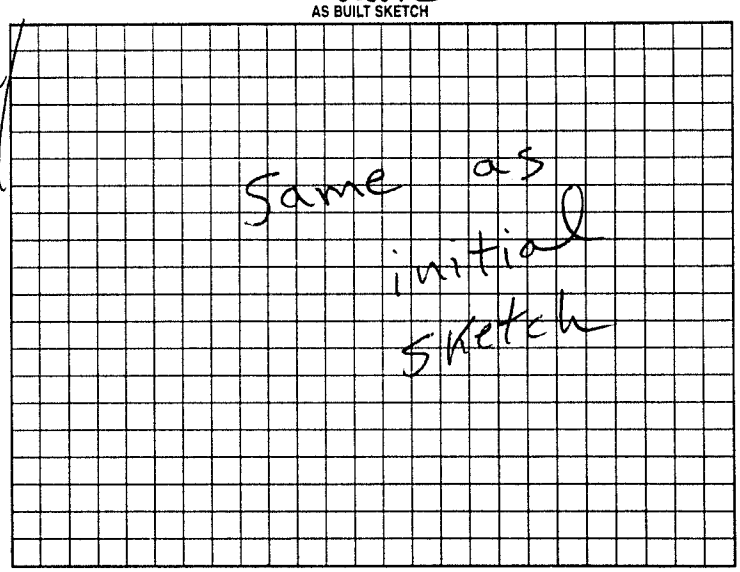

Permit can be suspended or revoked if any false information is supplied toward securing the permit/any unauthorized changes are made to the site/any unauthorized changes are made in the installation of the system. Improvement Permit with plat valid without expiration. Improvement Permit with site plan valid for sixty months. Authorization to Construct is valid for a period equal to that of Improvement Permit – not to exceed sixty months.

Signed: X. Daire Shupe 3'X80' date _____

Improvement Permit by: J.C. moore date _____

Authorization to Construct by: 3'X80' J.C. moore date _____

Installed by: Wayne Clontz

Operation Permit by: J.C. moore date 12-1-99

Existing System Inspection by: _____ date _____

HEALTH DEPT. COPY: WHITE OWNER COPY (FINAL): YELLOW OWNER COPY (INITIAL): PINK