IREDELL COUNTY HEALTH DEPARTMENT

STATESVILLE 704-878-5305 MOORESVILLE 704-664-5281

IMPROVEMENT PERMIT / AUTHORIZATION TO CONSTRUCT / OPERATION PERMIT / EXISTING SYSTEM INSPECTION

PERMIT# 090469 PIN# 4757 19 3622 DATE 7/17/00

OWNER OR CONTRACTOR Jeff Sharpe PHONE: Business 876-1296 Home

ADDRESS 593 Black Welder Rd. Statesville, NC. 28625

LOCATION 2 IN TL Jennings Rd. TR Black Welder - 1 mile on TL

SUBDIVISION No BLOCK / SECTION LOT LOT AREA ~25 AC SITE CLASS PS DESIGN FLOW 240 L.T.A.R. .3

Septic Tank: 1000 Gallons: STB 1012 Date 5-15-00

Pump Tank: Gallons: PT Date

Pump Make: Model Serial No.

Nitrification Field: No Fields 1 Square Feet 800 Linear Feet 267

No Lines 4067 Trench Width 36" Max Trench Bottom Depth 36" Gravel Depth 12

[X] New System [ ] Repair System Type: I (II) III. IV. V. VI

System Description: Gravity - Conventional

Repair System Description: Pressure - CH Plastic

Maintenance Agreement Required: [ ] Yes [X] No

[ ] House/Mod. Home [X] Mobile Home [ ] Business [ ] Other

No. Bedrooms 2 No. Bathrooms 2 No. Employees

[ ] Slab [X] Crawl Space [ ] Basement w/plumbing [ ] Basement wo/plumbing


Water Supply: [ ] Individual [ ] Public [X] Community

Comments:/Conditions:


Repair - Pressure Dist

Comments:/Conditions: ① SYSTEM INSTALLED ON CONTOUR AS SHOWN ② SEPTIC TANK WITH RISERS INSTALLED USING "POLYLOK" FILTERS

INITIAL SITE SKETCH

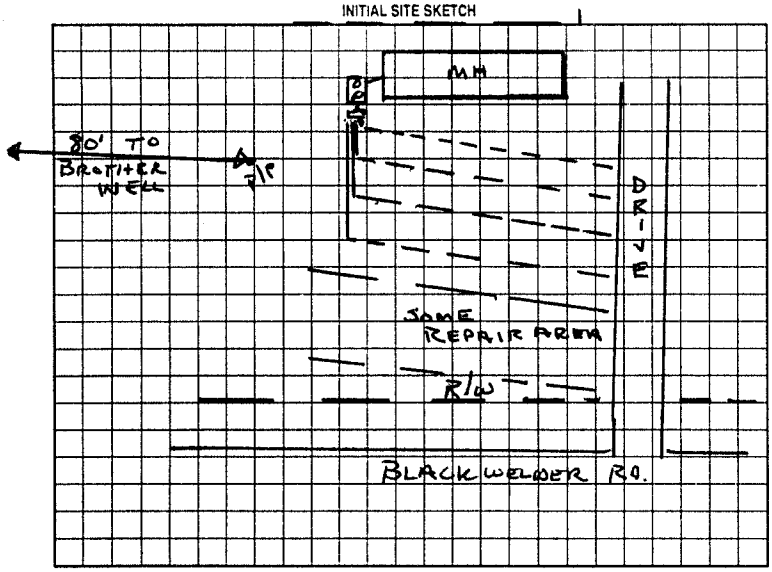

AS BUILT SKETCH

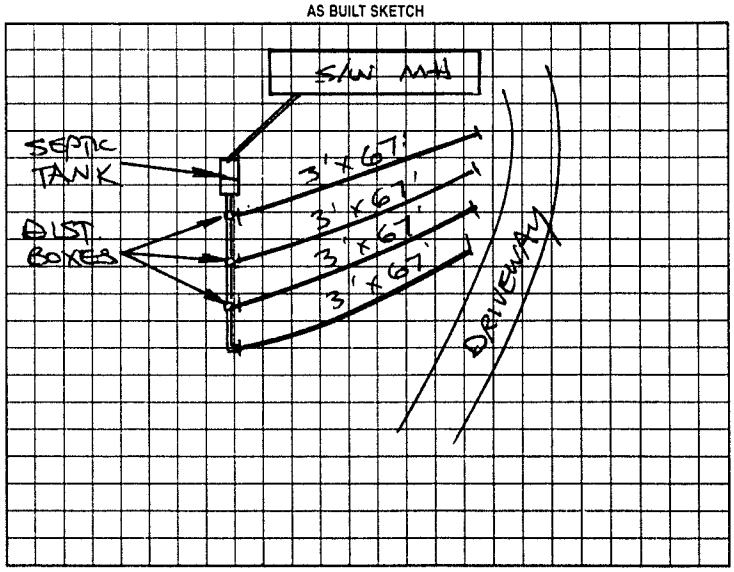

Permit can be suspended or revoked if any false information is supplied toward securing the permit/any unauthorized changes are made to the site/any unauthorized changes are made in the installation of the system. Improvement Permit with plat valid without expiration. Improvement Permit with site plan valid for sixty months. Authorization to Construct is valid for a period equal to that of Improvement Permit – not to exceed sixty months.

Signed: Jeffrey W. Sharpe date

Improvement Permit by: Wesley Sparks RS. date 7/17/00

Authorization to Construct by: Wesley Sparks RS. date 7/17/00

Installed by: TOMMY FRYE

Operation Permit by: STEVE HEDRICK date 7-26-00

Existing System Inspection by: date

HEALTH DEPT. COPY: WHITE OWNER COPY (FINAL): YELLOW OWNER COPY (INITIAL): PINK