2:30

IREDELL COUNTY HEALTH DEPARTMENT - *ENVIRONMENTAL HEALTH*

☑ STATESVILLE OFFICE 704-878-5305 ☐ MOORESVILLE OFFICE 704-664-5281

IMPROVEMENT PERMIT / AUTHORIZATION TO CONSTRUCT (I) / OPERATION PERMIT / EXISTING SYSTEM INSPECTION

PERMIT # 171856 PIN # 4758209690 DATE 5-3-12

OWNER Willard Blackwelder APPLICANT: Same PHONE: Home/Cell # 704 880 1913 Business # N/A

SITE ADDRESS 465 Blackwelder Rd. Statesville OWNER / APPLICANT ADDRESS 457 Blackwelder Rd. Statesville


SITE DIRECTIONS Hwy 21; L on Jennings Rd.; R on Blackwelder Rd.; Approx 2 miles on Right

SUBDIVISION N/A BLOCK / SECTION N/A LOT # N/A LOT AREA ~2700 Ft² DESIGN FLOW 360 gpd. L.T.A.R. 0.25


Septic Tank 1000	Gallons: STB 1012	Date 2-6-12	☑ New System	☐ Repair	☐ Expansion System	Type I II (III) IV V VI	☑ Residence	No. Bedrooms 3	Water Supply
Pump Tank	Gallons: PT	Date	System Description: 25% Red.				☐ Business	No. Persons	☐ Private
Pump Make	Model	Serial #	Repair System Description: 25% Red.				☐ Other	No. Employees	☑ Public
No. Nitrification Fields: 1	No. Lines	Linear Feet	Maintenance Agreement Required ☐ YES ☑ NO				☐ Slab	☑ Crawl Space	☐ Community
Trench Width 36"	Max. Trench Bottom Depth 36"		Gravel Depth	☑ GRAVITY	☐ PRESSURE		☐ Basement w/plumbing	☐ Basement w/o plumbing	

Comments / Conditions: Install 25% Reduction system on contour with serial distribution.

INITIAL SITE SKETCH

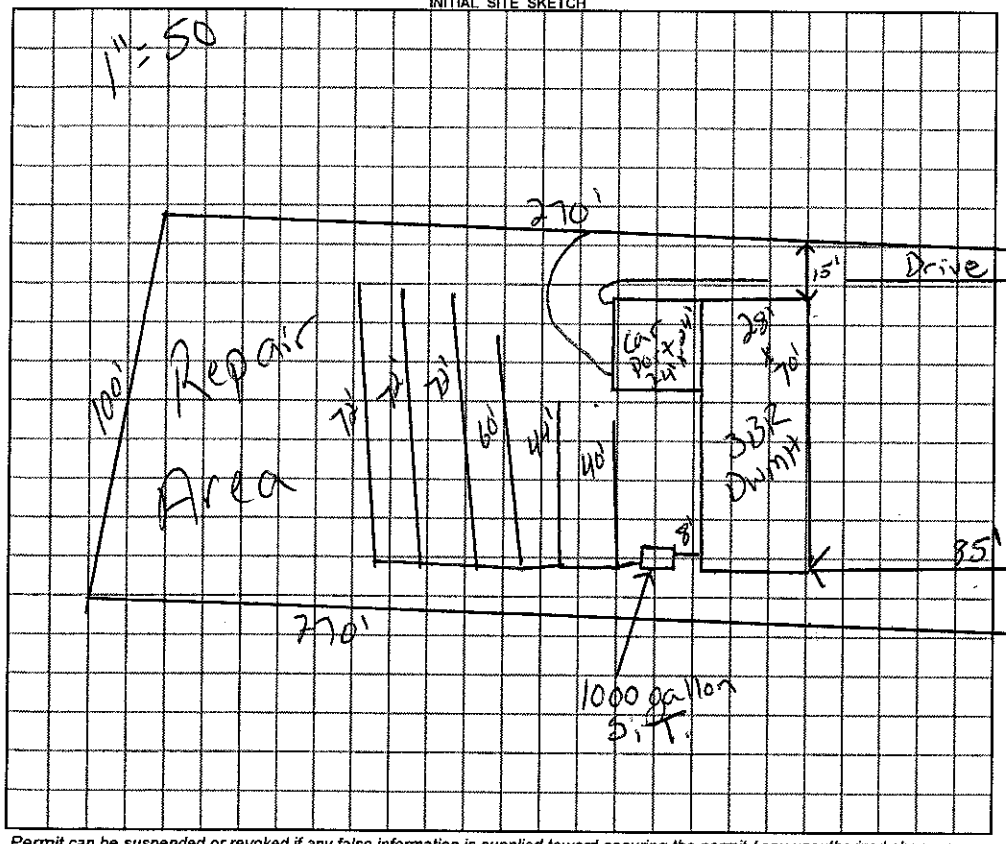

AS BUILT SKETCH

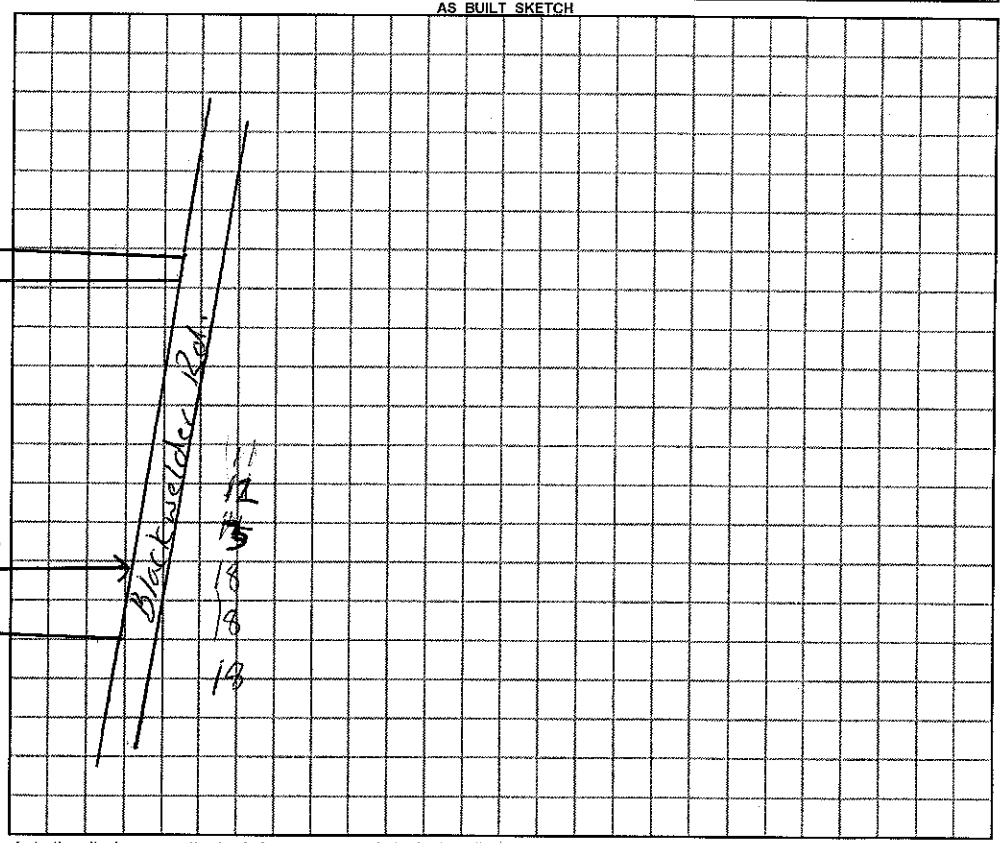

Permit can be suspended or revoked if any false information is supplied toward securing the permit / any unauthorized changes are made to the site / any unauthorized changes are made in the installation of the system.

☐ *IMPROVEMENT PERMIT with plat valid without expiration.* ☑ *IMPROVEMENT PERMIT with plat ~~valid without expiration.~~ site plan valid 60 mo.* ☑ *AUTHORIZATION TO CONSTRUCT* valid for period equal to IMPROVEMENT PERMIT--not to exceed 60 mo.

Owner / Applicant Signature: Willard Blackwelder Date 5-9-12

IMPROVEMENT PERMIT by: Justin Henderson REHS Date 5-3-12

AUTHORIZATION TO CONSTRUCT by: Justin Henderson REHS Date 5-3-12

YOU SHOULD CONTACT A LOCATOR SERVICE PRIOR TO ANY EXCAVATION

Installed by: Tommy Frye

OPERATION PERMIT by: REHS Date 6-21-12

Existing System Inspected by: REHS Date

White Copy – Environmental Health YELLOW COPY (Final) Owner / Applicant PINK COPY (Initial) Owner / Applicant