IREDELL COUNTY HEALTH DEPARTMENT

STATESVILLE 704-878-5305 MOORESVILLE 704-664-5281

IMPROVEMENT PERMIT / AUTHORIZATION TO CONSTRUCT / OPERATION PERMIT / EXISTING SYSTEM INSPECTION

PERMIT# 143789 PIN# 4758382175 DATE 7-16-07

OWNER OR APPLICANT Helen Anderson PHONE: Business _____ Home 704 876 0241

ADDRESS 118 Smith Farm Rd

LOCATION 77N, exit 59, (R) on Tomlin Mill Rd, (R) on Fairmount, 2nd Paved Rd on Right Lundy 3/10 mile, Right Smith farm

SUBDIVISION n/a BLOCK / SECTION _____ LOT _____ LOT AREA 2024 SITE CLASS. _____ DESIGN FLOW 3 L.T.A.R. Ex

Septic Tank: Ex. Gallons: STB _____ Date _____

Pump Tank: _____ Gallons: PT _____ Date _____

Pump Make: _____ Model _____ Serial No. _____

Nitrification Field: No Fields Ex Square Feet Ex. Linear Feet Ex.

No Lines Ex. Trench Width Ex. Max Trench Bottom Depth Ex. Gravel Depth Ex.

☐ Gravity ☐ Pressure

☐ New System ☐ Repair ☐ Expansion System Type: (II) III IV V VI

System Description: Existing

Repair System Description: _____

Maintenance Agreement Required: ☐ Yes ☑ No

☐ House/Mod. Home ☒ Mobile Home ☐ Business ☐ Other _____

No. Bedrooms 3 No. Persons _____ No. Employees _____

Water Supply: ☒ Individual ☐ Public ☐ Community


☐ Slab ☒ Crawl Space ☐ Basement w/plumbing ☐ Basement wo/plumbing

Comments:/Conditions:

Comments:/Conditions:

INITIAL SITE SKETCH

AS BUILT SKETCH

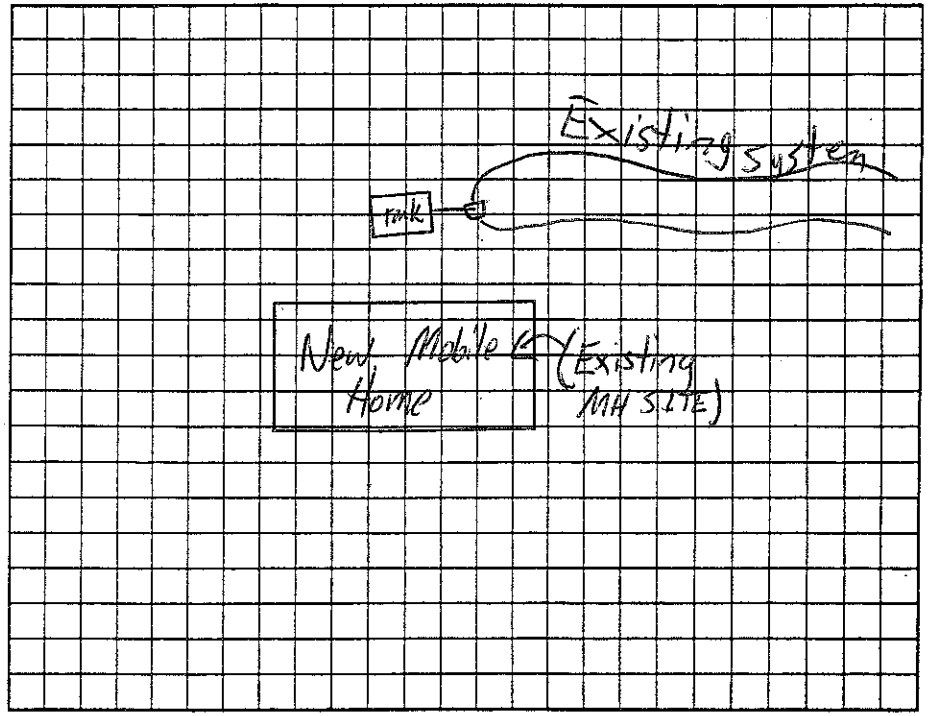

Permit can be suspended or revoked if any false information is supplied toward securing the permit/any unauthorized changes are made to the site/any unauthorized changes are made in the installation of the system. Improvement Permit with plat valid without expiration ☐ Improvement Permit with site plan valid for sixty months ☐ Authorization to Construct is valid for a period equal to that of Improvement Permit – not to exceed sixty months.

Signed: Helen L. Anderson date 16 July 07

Improvement Permit by: _____ date _____

Authorization to Construct by: _____ date _____

Installed by: _____

Operation Permit by: _____ date _____

Existing System Inspection by: _____ date 7-16-07

HEALTH DEPT. COPY: WHITE OWNER COPY (FINAL): YELLOW OWNER COPY (INITIAL): PINK