IREDELL COUNTY HEALTH DEPARTMENT

STATESVILLE 704-878-5305 MOORESVILLE 704-664-5281

IMPROVEMENT PERMIT / CERTIFICATE OF COMPLETION / OPERATION PERMIT / EXISTING SYSTEM INSPECTION

PROPERTY DESCRIPTION NO. 065945 DATE 5-5-97 TAX MAP NO. 4758399020 Watershed: ☐ Yes ☒ No

OWNER OR CONTRACTOR RUBY FRAZIER PHONE: Business _____ Home 892-8929

ADDRESS 10500 WASHAM POTTS ROAD,

LOCATION US 21 N, TL FAIRMOUNT RD, TL JOHOBE DRIVE 1ST LOT ON LEFT

SUBDIVISION _____ BLOCK / SECTION _____ LOT _____ LOT AREA 2.51 ACRES SITE CLASS. PS DESIGN FLOW 360 L.T.A.R. 0.35 GPD/FT²

Septic Tank: 1000 Gallons; STB 1012 Date 5-27-97

Pump Tank: _____ Gallons; PT _____ Date _____

Pump Make: _____ Model _____ Serial No. _____

Nitrification Field: No Fields 1 Square Feet 1035 Linear Feet 345

No Lines THREE Trench Width 36" Max Trench Bottom Depth 36" Gravel Depth 12"

☒ New System ☐ Repair System Type: I, II, III, IV, V, VI

System Description: CONV. GRAVITY

Repair System Description: CONV. PUMP

Maintenance Agreement Required; ☐ Yes ☒ No

☐ House/Mod. Home ☒ Mobile Home ☐ Business ☐ Other

No. Bedrooms 3 No. Bathrooms 2 No. Employees ____


☐ Slab ☒ Crawl Space ☐ Basement w/plumbing ☐ Basement wo/plumbing

Water Supply: ☐ Individual ☐ Community ☒ Public

Comments: REWORK EXISTING SURFACE DITCH TO PROVIDE DRAINAGE FROM DRIVE AWAY FROM DRAINFIELD

Comments:

INITIAL SITE SKETCH

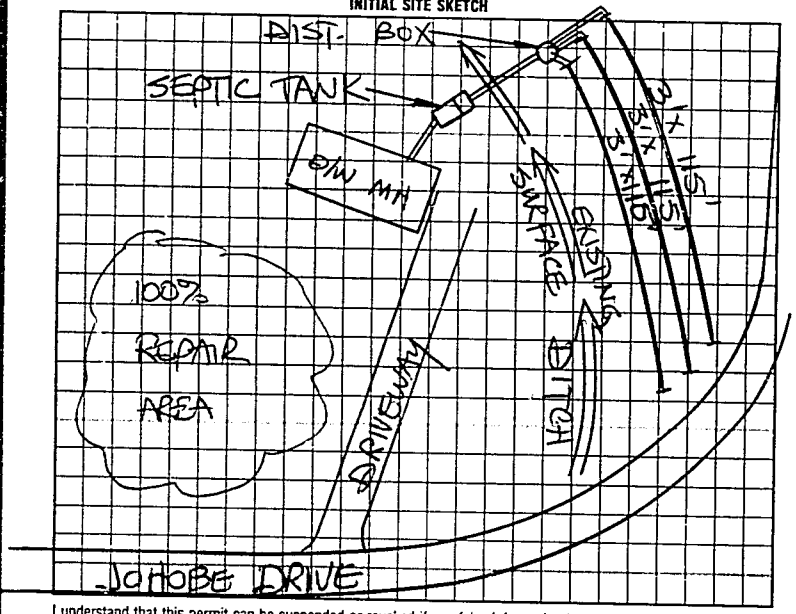

AS BUILT SKETCH

SYSTEM INSTALLED ACCORDING TO INITIAL SITE SKETCH

I understand that this permit can be suspended or revoked if any false information is supplied toward securing the permit/any unauthorized changes are made to the site/any unauthorized changes are made in the installation of the system. Improvement Permit is valid for 60 months from date of issuance. AUTHORIZATION TO CONSTRUCT IS VALID FOR 60 MONTHS FROM DATE OF ISSUANCE.

Signed: _____

Improvement Permit by: STEVE HEDRICK date 5-5-97

Existing System Inspection by: STEVE HEDRICK date 5-5-97

Installed by: KENNY MADISON

~~Certificate of Completion by:~~ _____ date _____

Operation Permit by STEVE HEDRICK date 5-27-97

HEALTH DEPT COPY WHITE — INSPECTION COPY (FINAL) GREEN — OWNER COPY (FINAL) YELLOW — INSPECTION COPY (INITIAL) PINK — OWNER COPY (INITIAL) GOLD