IREDELL COUNTY HEALTH DEPARTMENT

STATESVILLE 704-878-5305 MOORESVILLE 704-664-5281

IMPROVEMENT PERMIT / AUTHORIZATION TO CONSTRUCT / OPERATION PERMIT / EXISTING SYSTEM INSPECTION

PERMIT# REPAIR PIN# DATE 1-11-01

OWNER OR CONTRACTOR LISA B. DAGENHART PHONE: Business Home 876-1360

ADDRESS 345 FAIRMOUNT CH. RD, STATESVILLE, NC 28625

LOCATION US 21 N, TL FAIRMOUNT CH. RD, 1ST HOUSE ON LEFT PAST LUNAY ROAD

SUBDIVISION BLOCK / SECTION LOT LOT AREA AMPLE SITE CLASS PS DESIGN FLOW 240 L.T.A.R. 0.30 GAD/SQ FT

Septic Tank: 1000 Gallons; STB 794 Date 9-26-00
Pump Tank: Gallons; PT Date
Pump Make: Model Serial No.
Nitrification Field: No Fields Square Feet Linear Feet EXISTING 270
No Lines Trench Width Max Trench Bottom Depth Gravel Depth

☐ New System ☑ Repair System Type: I. II. III. IV. V. VI
System Description:
Repair System Description: CONV. GRAVITY
Maintenance Agreement Required: ☐ Yes ☑ No
☐ Slab ☑ Crawl Space ☐ Basement w/plumbing ☐ Basement wo/plumbing


☐ House/Mod. Home No. Bedrooms 3
☐ Mobile Home No. Bathrooms 1
☐ Business No. Employees
☐ Other

Water Supply: ☐ Individual ☑ Public ☐ Community


Comments/Conditions: PUMP OUT EXISTING SEPTIC TANK AND ABANDON BY CRUSHING AND FILLING WITH DIRT FROM NEW TANK HOLE.

Comments/Conditions: SYSTEM SIZED FOR TWO BEDROOMS ONLY
SEPTIC TANK WITH MARKER INSTALLED USING "THETTE" FILTER

INITIAL SITE SKETCH

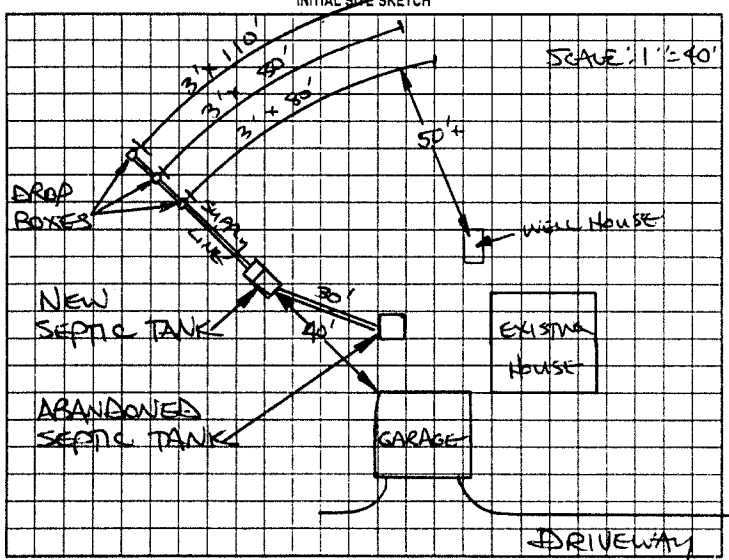

AS BUILT SKETCH

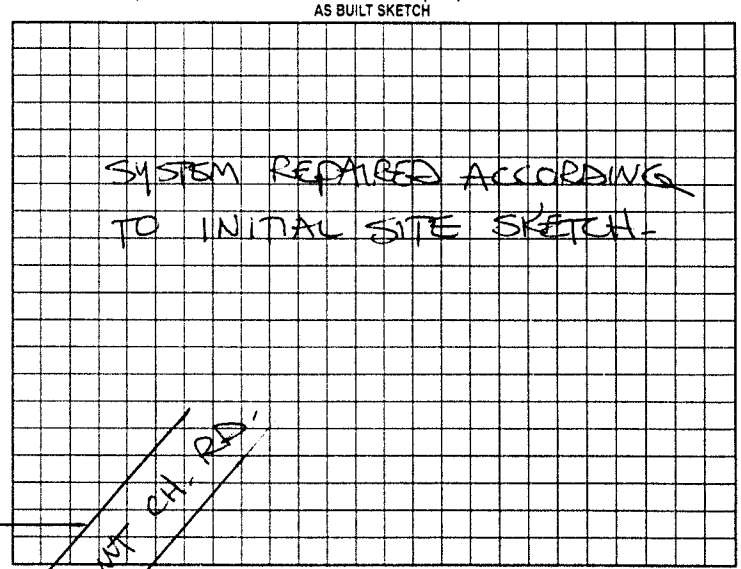

Permit can be suspended or revoked if any false information is supplied toward securing the permit/any unauthorized changes are made to the site/any unauthorized changes are made in the installation of the system. Improvement Permit with plat valid without expiration. Improvement Permit with site plan valid for sixty months. Authorization to Construct is valid for a period equal to that of Improvement Permit – not to exceed sixty months.

Signed: Lisa B Dagenhart date 1/11/01 Installed by: LLOYD'S BACKHOE & GRADING

Improvement Permit by: STEVE HEDRICK date 1-11-01 Operation Permit by: STEVE HEDRICK date 1-17-01

Authorization to Construct by: STEVE HEDRICK date 1-11-01 Existing System Inspection by: date

HEALTH DEPT COPY WHITE OWNER COPY (FINAL) YELLOW OWNER COPY (INITIAL) PINK