11:30

IREDELL COUNTY HEALTH DEPARTMENT

STATESVILLE 704-878-5305 MOORESVILLE 704-664-5281 T Type

IMPROVEMENT PERMIT / AUTHORIZATION TO CONSTRUCT / OPERATION PERMIT / EXISTING SYSTEM INSPECTION

PERMIT# 088638 PIN# 4758 50 6963 DATE 5-12-2000

OWNER OR CONTRACTOR JAMES BLACKWELDER PHONE: Business Home 876-0349

ADDRESS 416 BLACKWELDER RD STATESVILLE, NC 28625

LOCATION U.S 21 NORTH TL BLACKWELDER ROAD, 0.7 MILE ON RIGHT

SUBDIVISION BLOCK/SECTION LOT LOT AREA 5509 Acres SITE CLASS PS DESIGN FLOW 360 L.T.A.R. 0.3 GPD/FT²

Septic Tank: 1000 Gallons; STB 1012 Date 2-7-00
Pump Tank: Gallons; PT Date
Pump Make: Model Serial No.
Nitrification Field: No Fields 1 Square Feet 1200 Linear Feet 400
No Lines FIVE Trench Width 36" Max Trench Bottom Depth 36" Gravel Depth 12"

☑ New System ☐ Repair System Type: I II III IV V VI
System Description: CONVENTIONAL GRAVITY
Repair System Description: CONV. PUMP
Maintenance Agreement Required: ☐ Yes ☑ No


☑ House/Mod. Home No. Bedrooms 3
☑ Mobile Home No. Bathrooms 2
☐ Business No. Employees
☐ Other
☐ Slab ☑ Crawl Space ☐ Basement w/plumbing ☐ Basement wo/plumbing

Water Supply: ☐ Individual ☑ Public ☐ Community

Comments/Conditions:

Comments/Conditions:

INITIAL SITE SKETCH ~ SCALE: 1" = 40'

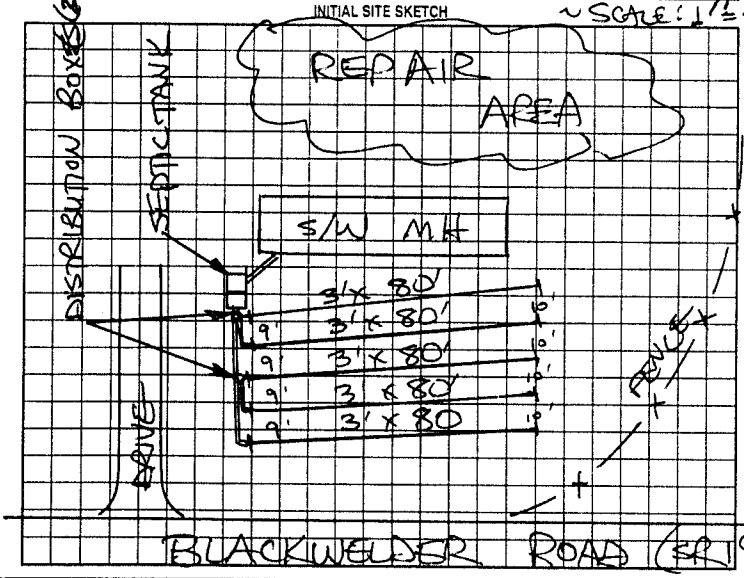

AS BUILT SKETCH

System Installed As Designed

Permit can be suspended or revoked if any false information is supplied toward securing the permit/any unauthorized changes are made to the site/any unauthorized changes are made in the installation of the system. Improvement Permit with plat valid without expiration. Improvement Permit with site plan valid for sixty months. Authorization to Construct is valid for a period equal to that of Improvement Permit – not to exceed sixty months.

Signed: James M. Blackwelder date 5-12-00 Installed by: Tommy Frye

Improvement Permit by: STEVE HEDRICK date 5-12-00 Operation Permit by: [illegible] date June 6 2000

Authorization to Construct by: STEVE HEDRICK date 5-12-00 Existing System Inspection by: date

HEALTH DEPT. COPY WHITE OWNER COPY (FINAL) YELLOW OWNER COPY (INITIAL) PINK