# IREDELL COUNTY HEALTH DEPARTMENT

Statesville Office (704) 878-5305 Mooresville Office (704) 660-3625 PERMIT # 177403

## IMPROVEMENT PERMIT / AUTHORIZATION TO CONSTRUCT / OPERATION PERMIT / EXISTING SYSTEM

PIN # 4758778534

APPLICANT: Ashley McCracken APPLICANT ADDRESS: 112 Windrow Ln.

SITE ADDRESS: 112 Windrow Ln. PHONE: 304-639-2184 ALT. PHONE: N/A

SITE DIRECTIONS: Hwy 21 N TL Fairmount Rd. TL Windrow 3rd House on right


SUBDIVISION: Fairmount Fields SECTION: N/A LOT # 14 LOT AREA: 0.48 acres DESIGN FLOW: 360gpd L.T.A.R.: 0.3

| | | | | | | | | | |
|---|---|---|---|---|---|---|---|---|---|
| Septic Tank | Existing (gal) | STB | Date | ☐ New System | ☑ Repair | ☐ Expansion | System Type: I II ☒ III IV V VI | ☑ Residence | No. Bedrooms 3 |
| Pump Tank | (gal) | PT | Date | System Description: | | | | ☐ Business | No. Persons |
| Pump Make | Model | | Serial # | Repair System Description: | 25% Reduction | | | ☐ Other | No. Employees |
| # Nitrification Fields | 1 # Lines | 6 | Linear Ft: 212 | Maintenance Agreement Required: | ☐ YES | ☑ NO | | ☐ Slab | ☑ Crawl Space |
| Trench Width | 36" Max. Trench Bottom Depth | 36" | Gravel Depth N/A | | ☑ GRAVITY | ☐ PRESSURE | | ☐ Basement w/plumbing | ☐ Basement w/o plumbing |

**Water Supply**: ☐ Private ☑ Public ☐ Community

Comments / Conditions: Install a 25% Reduction System on contour with serial distribution. Extend each existing line 28' as shown in drawing. Pipe gutters off below nitrification field. Grade to shed water away from septic tank location

INITIAL SITE SKETCH

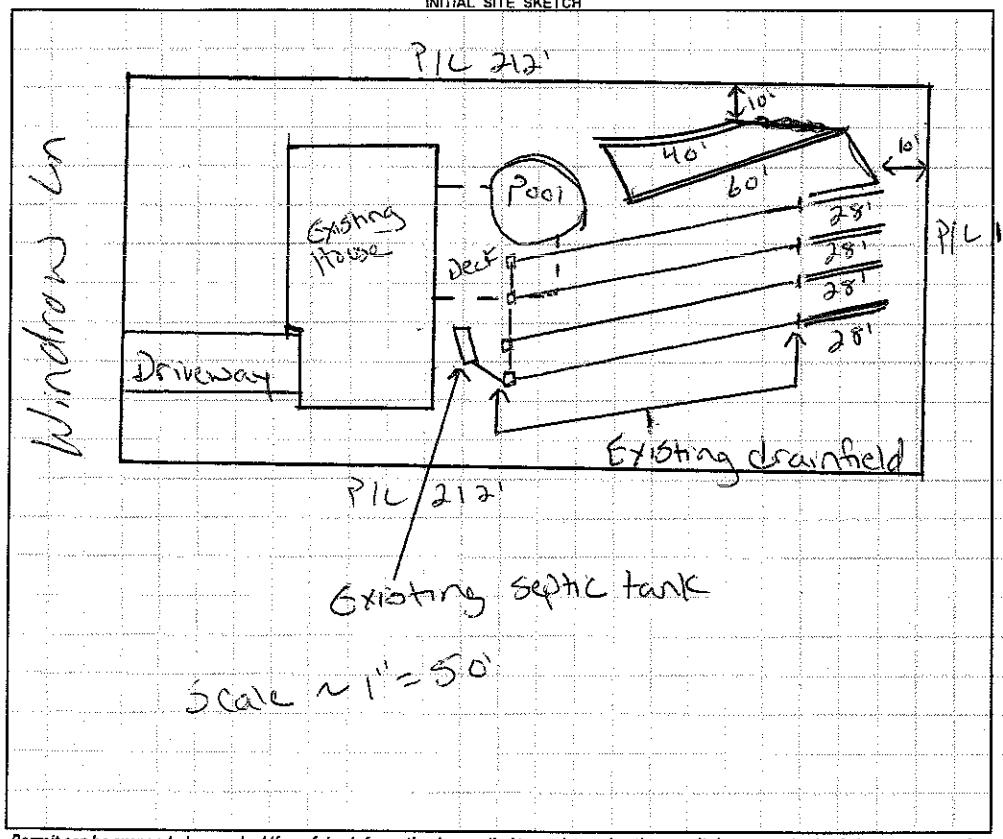


AS BUILT SKETCH

Installed as drawn.

*Permit can be suspended or revoked if any false information is supplied toward securing the permit / any unauthorized changes are made to the site / any unauthorized changes are made in the installation of the system.* **CONTACT A LOCATOR SERVICE PRIOR TO ANY EXCAVATION**

☐ **IMPROVEMENT PERMIT** ***with plat*** *valid without expiration.* ☑ **IMPROVEMENT PERMIT** ***with site plan*** *valid for 60 mos.* ☑ **AUTHORIZATION TO CONSTRUCT** *valid for period equal to IMPROVEMENT PERMIT--not to exceed 60 mo.*

Owner / Applicant Signature: Jason Combs Date: 3-6-13 Installed by: K & M Grading

IMPROVEMENT PERMIT by: Justin Henderson Date: 3-5-13 OPERATION PERMIT by: Justin Henderson Date: 3-20-13

AUTHORIZATION TO CONSTRUCT by: Justin Henderson Date: 3-5-13 Existing System Inspected by: Date:

Health Dept. Copy - WHITE Applicant (Final Approval) - YELLOW Applicant (Conditional Approval) - PINK