1208

IREDELL COUNTY HEALTH DEPARTMENT

STATESVILLE 704-878-5305 CI MOORESVILLE 704-664-5281

IMPROVEMENT PERMIT / AUTHORIZATION TO CONSTRUCT / OPERATION PERMIT / EXISTING SYSTEM INSPECTION

PERMIT# 126810 PIN# ~~4758-87-0273~~ 4758870273 DATE 4-22-05

OWNER OR CONTRACTOR ~~JAN T~~ PETREE/Styron Bldrs. PHONE: Business (704) 902-4607/4608 Home 704-873-5367

ADDRESS 2700 TRENT PINES CT SHERRILLS FORD, NC 28673-9132

LOCATION I-77N TR TOMLIN MILL TR FAIRMOUNT, TR WINDROW 6TH LOT ON LEFT

SUBDIVISION FAIRMOUNT FIELDS BLOCK / SECTION ____ LOT 6 LOT AREA 0.484 SITE CLASS. PS DESIGN FLOW 360 L.T.A.R. 0.30 gpd/ft²

Septic Tank: 1000 Gallons; STB 1012 Date 11-16-06
Pump Tank: ____ Gallons; PT ____ Date ____
Pump Make: ____ Model ____ Serial No. ____
Nitrification Field: No Fields 1 Square Feet 1200 Linear Feet 300
No Lines 3 Trench Width 36" Max Trench Bottom Depth 24" Gravel Depth N/A

☑ New System ☐ Repair System Type: I, II, (III) IV, V, VI
System Description: GRAVITY 25% REDUCTION
Repair System Description: LP PANEL 50% REDUCTION
Maintenance Agreement Required: ☐ Yes ☑ No


☑ House/Mod. Home No. Bedrooms 3
☐ Mobile Home No. Bathrooms ____
☐ Business No. Employees ____
☐ Other ____
☐ Slab ☑ Crawl Space ☐ Basement w/plumbing ☐ Basement wo/plumbing

Water Supply: ☐ Individual ☑ Public ☐ Community


Comments:/Conditions: (1) INSTALL LINES 24" ON CONTOUR (2) MAINTAIN SETBACKS (3) GRADE OFF BERM ON LOWER SIDE OF LOT (4) ELEVATION OF PLUMBING CRITICAL OR WILL HAVE TO PUMP (5) BACKFILL OR PERMIT WILL BE VOID (6) NO FOUNDATION DRAIN OR ~~INITIAL SITE SKETCH~~ PERMIT WILL BE VOID (7) IF A 24" TRENCH BOTTOM CANNOT BE MAINTAINED, A PUMP WILL BE REQUIRED

Comments:/Conditions: Yellow Tuf-tite ST marker

INITIAL SITE SKETCH

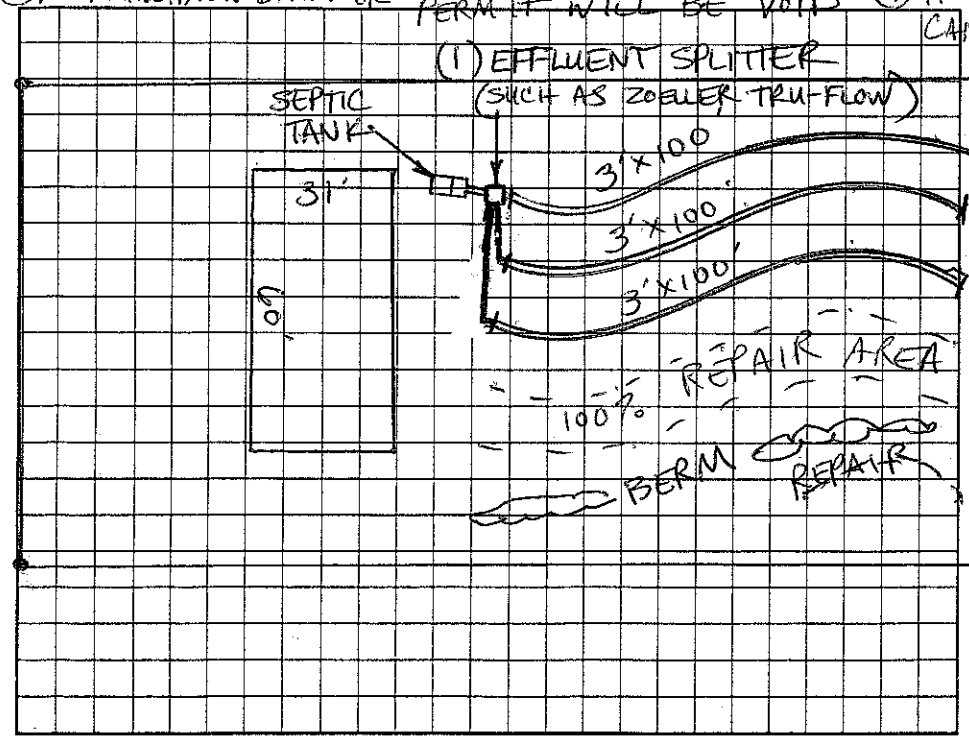

AS BUILT SKETCH

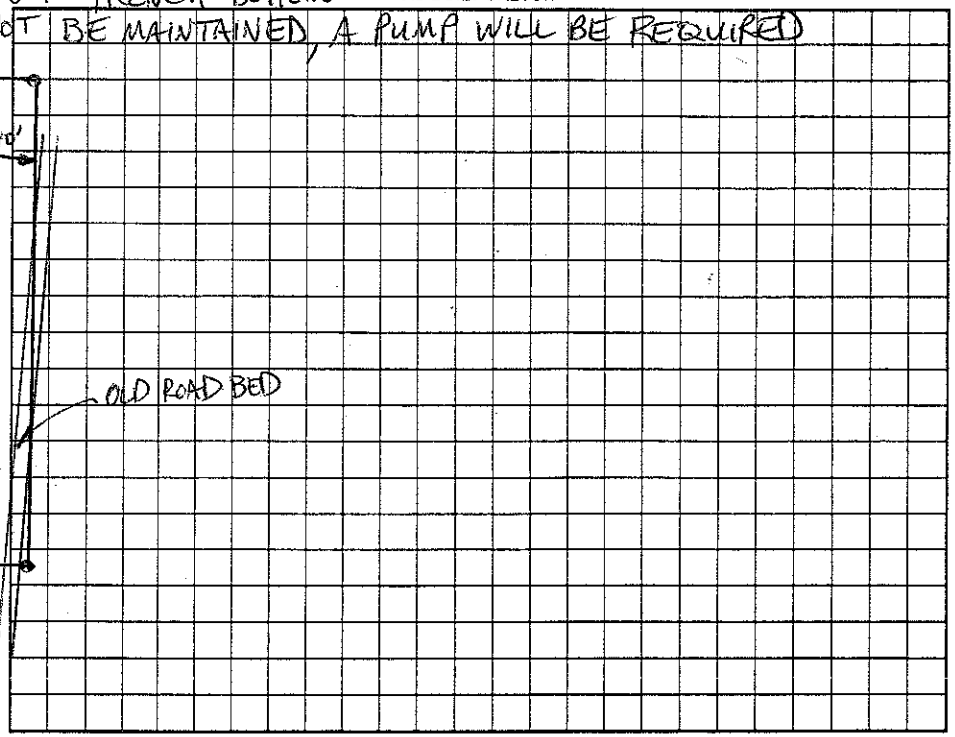

Permit can be suspended or revoked if any false information is supplied toward securing the permit/any unauthorized changes are made to the site/any unauthorized changes are made in the installation of the system. Improvement Permit with plat valid without expiration. ~~Improvement~~ Permit with site plan valid for sixty months. Authorization to Construct is valid for a period equal to that of Improvement Permit – not to exceed sixty months.

Signed: Jan Petree date 8/30/05 Installed by: Kevin Construction

Improvement Permit by: Christopher M. Sherrill RS, LSS date 4-22-05 Operation Permit by: [signature] date 5-24-07

Authorization to Construct by: Christopher M. Sherrill RS, LSS date 4-22-05 Existing System Inspection by: ____ date ____

HEALTH DEPT. COPY: WHITE OWNER COPY (FINAL): YELLOW OWNER COPY (INITIAL): PINK