IREDELL COUNTY HEALTH DEPARTMENT

STATESVILLE 704-878-5305 155.00 Paid MOORESVILLE 704-664-5281

IMPROVEMENT PERMIT / AUTHORIZATION TO CONSTRUCT / OPERATION PERMIT / EXISTING SYSTEM INSPECTION

PERMIT# 103100 PIN# 4758 77 9368.5 87-0383 DATE 1/04/03

OWNER OR CONTRACTOR PETREE STYRON BUILDERS LLC PHONE: Business 873-5367 Home

ADDRESS 605 GREENBERRY DR. STATESVILLE NC 28625

LOCATION 21N - TL FAIRMOUNT - TL WINDROW - 5th ON LT

SUBDIVISION FAIRMOUNT FIELDS BLOCK / SECTION 000 LOT 5 LOT AREA .487 AC SITE CLASS. PS DESIGN FLOW 360 GPD L.T.A.R. .36 GPD/FT²

Septic Tank: 1000 Gallons; STB 1012 Date 5-8-04
Pump Tank: Gallons; PT Date
Pump Make: Model Serial No.
Nitrification Field: No Fields 1 Square Feet 400 Linear Feet 300
No Lines 4@75' Trench Width 36" Max Trench Bottom Depth 36" Gravel Depth N/A

☑ New System ☐ Repair System Type: I, II, III, IV, V, VI
System Description: GRAVITY 25% REDUCTION
Repair System Description: LP PANEL
Maintenance Agreement Required: ☐ Yes ☑ No


☑ House/Mod. Home No. Bedrooms 3
☐ Mobile Home No. Bathrooms 3
☐ Business No. Employees
☐ Other
☐ Slab ☑ Crawl Space ☐ Basement w/plumbing ☐ Basement wo/plumbing

Water Supply: ☐ Individual ☑ Public ☐ Community

Comments:/Conditions:

Comments:/Conditions: Tuff tite Infiltrator chambers seal@end w/ mastic Riser 6" on tank

INITIAL SITE SKETCH 1"=60'

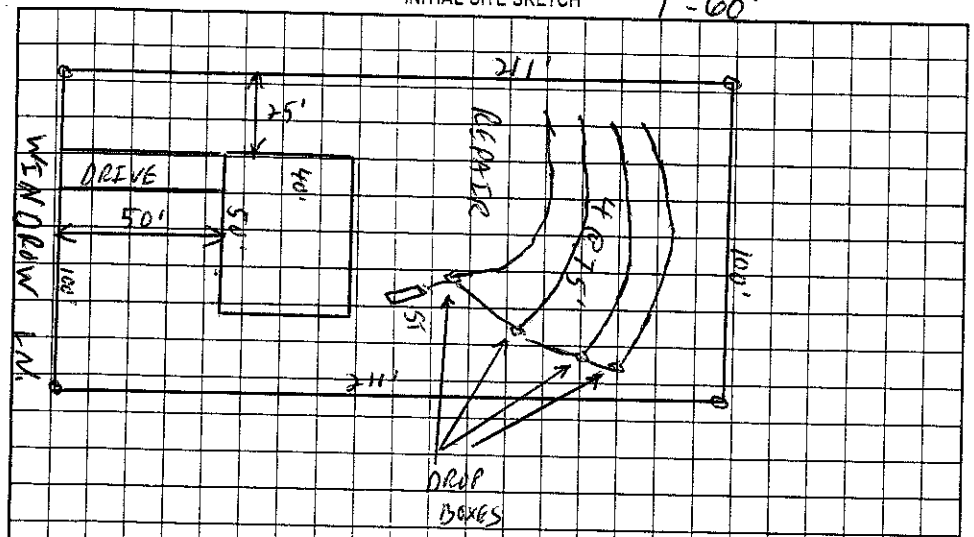

AS BUILT SKETCH

System installed according to sketch

Permit can be suspended or revoked if any false information is supplied toward securing the permit/any unauthorized changes are made to the site/any unauthorized changes are made in the installation of the system. Improvement Permit with plat valid without expiration. Improvement Permit with site plan valid for sixty months. Authorization to Construct is valid for a period equal to that of Improvement Permit – not to exceed sixty months.

Signed: date 1/21/03 Installed by: STEVE JORDAN

Improvement Permit by: KS date 1/04/03 Operation Permit by: KS date 10-11-04

Authorization to Construct by: KS date 1/04/03 Existing System Inspection by: date

HEALTH DEPT. COPY: WHITE OWNER COPY (FINAL): YELLOW OWNER COPY (INITIAL): PINK