IREDELL COUNTY HEALTH DEPARTMENT

CI // STATESVILLE 704-878-5305 155.00 Paid MOORESVILLE 704-664-5281

IMPROVEMENT PERMIT / AUTHORIZATION TO CONSTRUCT / OPERATION PERMIT / EXISTING SYSTEM INSPECTION

PERMIT# 103095 PIN# ~~4758 77 9368.9~~ 4758-87-0482 DATE 1/08/03

OWNER OR CONTRACTOR PETREE STYRON BUILDERS LLC PHONE: Business 873-5367 Home

ADDRESS 605 GREENBERRY DRIVE STATESVILLE NC 28625

LOCATION 21N - TL FAIRMOUNT - TL WINDROW - 4th ON LT.

SUBDIVISION FAIRMOUNT FIELDS BLOCK / SECTION LOT 4 LOT AREA .487 SITE CLASS. PS DESIGN FLOW 360.00 L.T.A.R. .36.00/K1

Septic Tank: 1000 Gallons; STB 1012 Date 3-1-03
Pump Tank: Gallons; PT Date
Pump Make: Model Serial No.
Nitrification Field: No Fields 1 Square Feet 900 Linear Feet 300
No Lines 4@75' Trench Width 36" Max Trench Bottom Depth 36" Gravel Depth N/A

☑ New System ☐ Repair System Type: I, II, III, IV, V, VI
System Description: GRAVITY 25% REDUCTION
Repair System Description: LP PANEL
Maintenance Agreement Required: ☐ Yes ☑ No

☑ House/Mod. Home No. Bedrooms 3
☐ Mobile Home No. Bathrooms 3
☐ Business No. Employees
☐ Other


☐ Slab ☑ Crawl Space ☐ Basement w/plumbing ☐ Basement wo/plumbing

Water Supply: ☐ Individual ☑ Public ☐ Community

Comments:/Conditions: 1) DRIVE ON EITHER SIDE

Comments:/Conditions: TOFFTITE FILTER + MARKER INSTALLED AS DRAWN

INITIAL SITE SKETCH 1"=60'

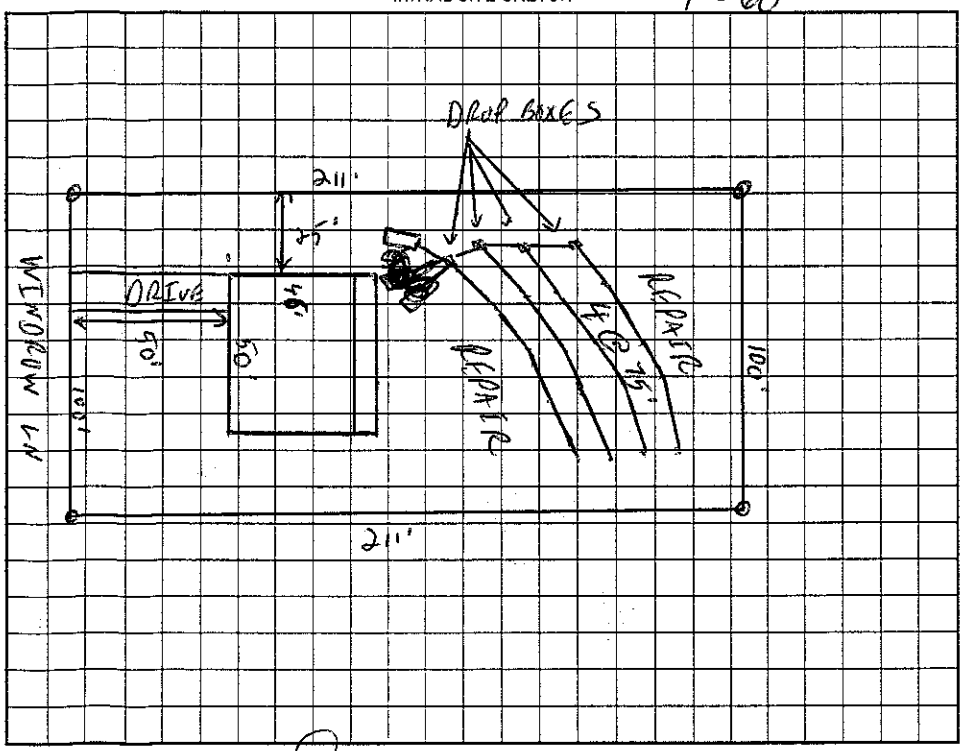

AS BUILT SKETCH

Permit can be suspended or revoked if any false information is supplied toward securing the permit/any unauthorized changes are made to the site/any unauthorized changes are made in the installation of the system. Improvement Permit with plat valid without expiration. Improvement Permit with site plan valid for sixty months. Authorization to Construct is valid for a period equal to that of Improvement Permit – not to exceed sixty months.

Signed: date 1/21/03 Installed by: STEVE JORDAN

Improvement Permit by: RS date 1/08/03 Operation Permit by: RS date

Authorization to Construct by: RS date 1/08/03 Existing System Inspection by: date

HEALTH DEPT. COPY: WHITE OWNER COPY (FINAL): YELLOW OWNER COPY (INITIAL): PINK