IREDELL COUNTY HEALTH DEPARTMENT

Statesville Phone TR 3-7271 Mooresville Phone NO 3-1271

PERMIT TO INSTALL SEPTIC TANK

Permit NO. 49 Permit Date 8-8 1972

Owner HEBRON Baptist Church Address Rt. 5 STATESVILLE, N C

Installed By HARLEE LACKEY Address Stony Point, N C.


Location of Property 21 N - 1st Road to LEFT PAST YADKIN RIVER - ON Rt.

Tank		Capacity		Length of Lines		Fixtures	
Block	( )	1000	( )	225'	( )	No. of Baths	(3)
Precast	(✓)	1250	( )	250'	( )	Dishwasher	( )
		1500	( )	Other 325~		Garbage Grdr.	( )
		Other				Other	

NOTIFY HEALTH DEPARTMENT AT LEAST EIGHT HOURS BEFORE TANK IS TO BE INSPECTED.

Final Inspection 8-8 1972 Approved (✓) Disapproved ( )

Remarks

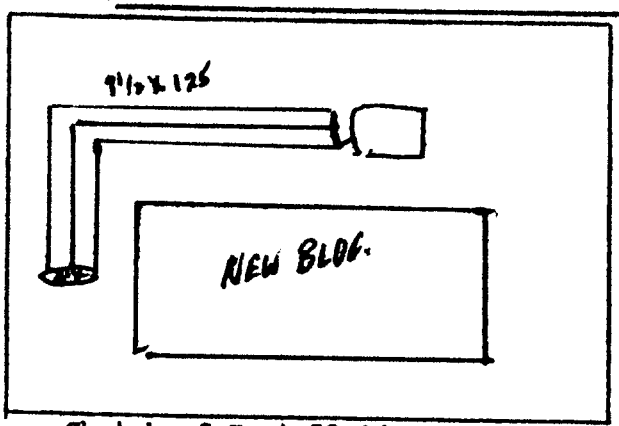

Sketch of Installation

Glenn Fox Jr.

Sanitarian