IREDELL COUNTY HEALTH DEPARTMENT

Statesville Phone TR 3-7271 Mooresville Phone NO 3-1271

PERMIT TO INSTALL SEPTIC TANK

Permit No. 112 Permit Date 8-30 1972

Owner FLAKE HENDERSON Address STATESVILLE, N.C.

Installed By HENRY NORMAN Address STATESVILLE, N.C.


Location of Property 21 N. TURN LEFT ON Rd #1914 BEFORE YADKIN RIVER - ON LEFT.

Tank		Capacity		Length of Lines		Fixtures	
Block	( )	1000	(✓)	225'	(✓)	No. of Baths	(✓)
Precast	(✓)	1250	( )	250'	( )	Dishwasher	( )
		1500	( )	Other		Garbage Grdr.	( )
		Other				Other	

NOTIFY HEALTH DEPARTMENT AT LEAST EIGHT HOURS BEFORE TANK IS TO BE INSPECTED.

Final Inspection 8-30 1972 Approved (✓) Disapproved ( )

Remarks NO WATER ON SITE AT TIME OF INSPECTION

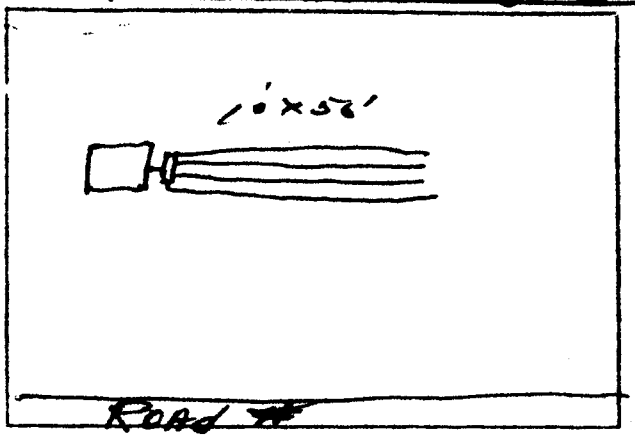

Sketch of Installation

Sanitarian