IREDELL COUNTY HEALTH DEPARTMENT - *ENVIRONMENTAL HEALTH* ☐ STATESVILLE OFFICE 704-878-5305 ☐ MOORESVILLE OFFICE 704-664-5281

IMPROVEMENT PERMIT / AUTHORIZATION TO CONSTRUCT / OPERATION PERMIT / EXISTING SYSTEM INSPECTION

PERMIT # 166175 PIN # 4758-94-1767 DATE JUNE 24, 2011

OWNER GIRL SCOUTS HORNETS NEST COUNCIL APPLICANT: PHONE: Home/Cell # 704-333-4161 Business # 704-731-6544

SITE ADDRESS 1919 TURNERSBURG HWY OWNER / APPLICANT ADDRESS

SITE DIRECTIONS US 21 N, CROSS S. YADKIN RIVER, 1ST DRIVE ON LEFT

SUBDIVISION BLOCK / SECTION LOT # ~~NOT ACRES~~ LOT AREA 161 ACRES DESIGN FLOW 340 GPD L.T.A.R. 0.30 GPD/FT

Septic Tank 1000 Gallons: STB 1012 Date 3-12-08 ☐ New System ☐ Repair ☐ Expansion System Type I (II) III IV V VI ☒ Residence No. Bedrooms 2 Water Supply

Pump Tank — Gallons: PT — Date — System Description: 25% REDUCTION ☒ Business RANGER HOME No. Persons 1 ☐ Private

Pump Make — Model — Serial # — Repair System Description: 25% REDUCTION ☐ Other MAINT. BLDG. No. Employees — ☒ Public


No. Nitrification Fields: 1 No. Lines 5 Linear Feet 300 Maintenance Agreement Required ☐ YES ☒ NO ☐ Slab ☒ Crawl Space ☐ Community

Trench Width 36 Max. Trench Bottom Depth 36 Gravel Depth N/A ☒ GRAVITY ☐ PRESSURE ☐ Basement w/plumbing ☐ Basement w/o plumbing


Comments / Conditions

SYSTEM SIZED TO ACCOMMODATE 2 BEDROOM HOUSE @ 240 GPD & MAINTENANCE BUILDING @ 100 GPD.

INITIAL SITE SKETCH

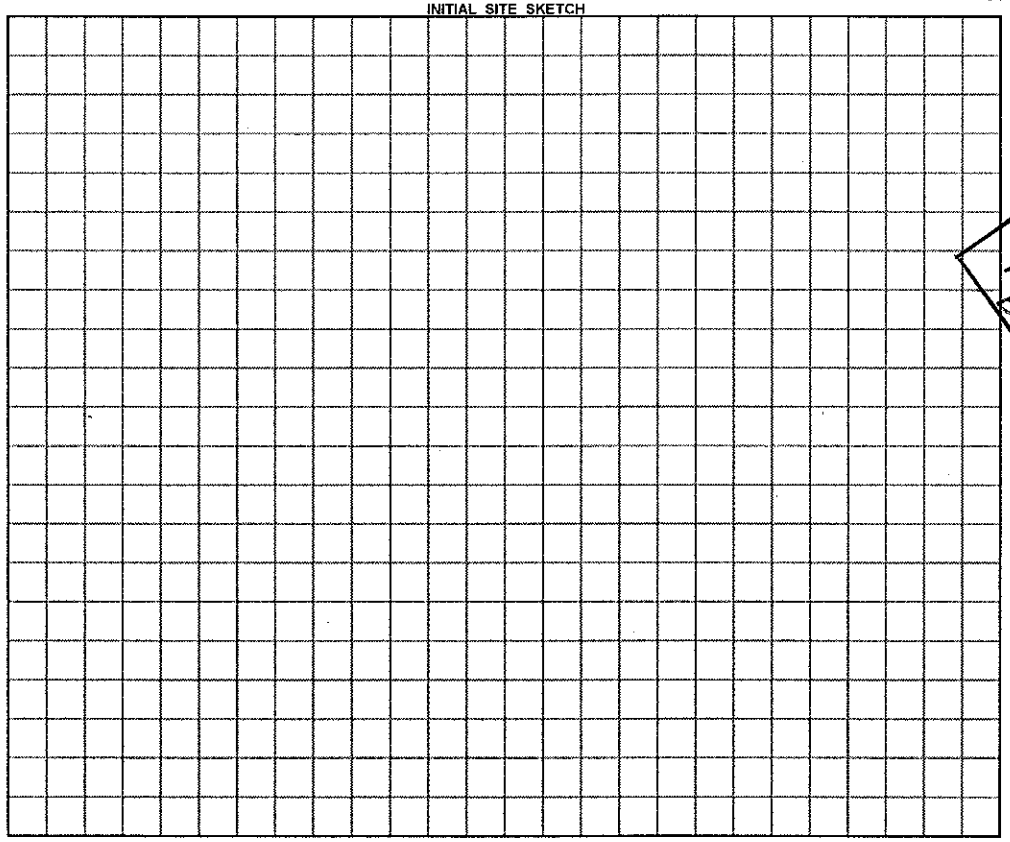

AS BUILT SKETCH

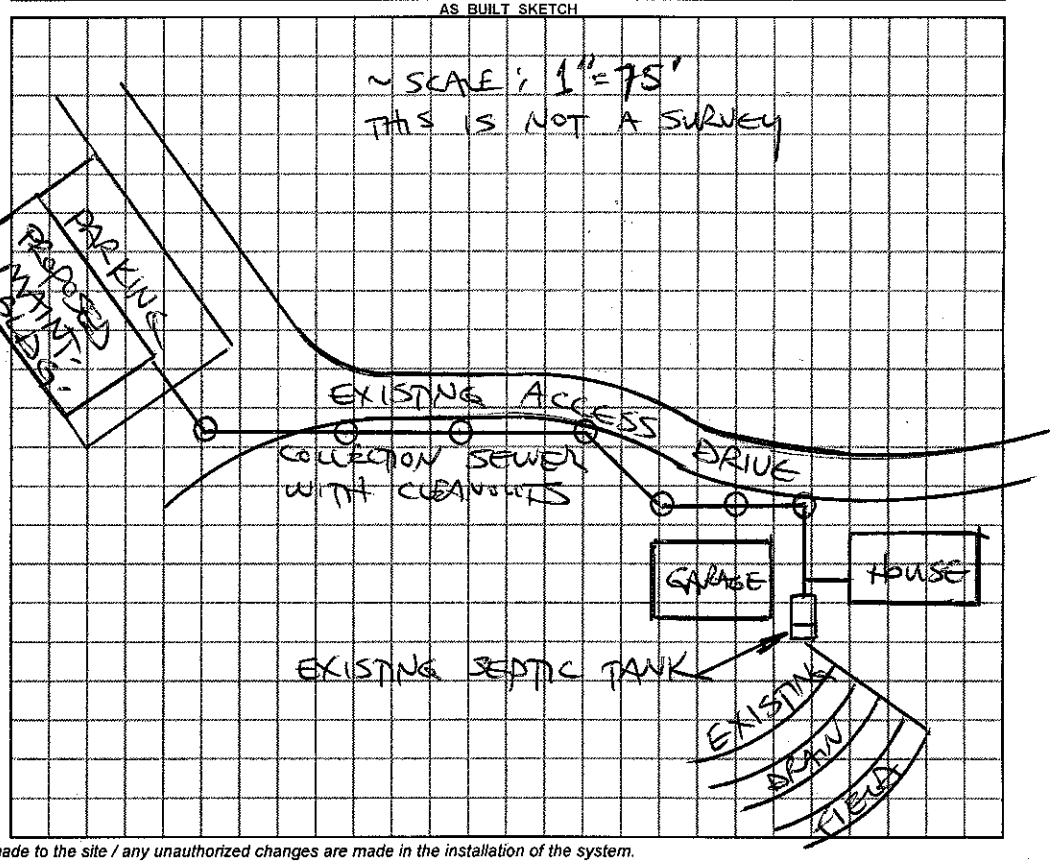

Permit can be suspended or revoked if any false information is supplied toward securing the permit / any unauthorized changes are made to the site / any unauthorized changes are made in the installation of the system.

☐ ***IMPROVEMENT PERMIT*** *with plat valid without expiration.* ☐ ***IMPROVEMENT PERMIT*** *with ~~plat valid without expiration.~~ site plan valid 60 mo.* ☐ ***AUTHORIZATION TO CONSTRUCT*** valid for period equal to IMPROVEMENT PERMIT--not to exceed 60 mo.

Owner / Applicant Signature: Date Installed by:

IMPROVEMENT PERMIT by: ***REHS*** Date OPERATION PERMIT by: ***REHS*** Date

AUTHORIZATION TO CONSTRUCT by: ***REHS*** Date Existing System Inspected by: STEVE HEDRICK ***REHS*** Date 6-24-11

YOU SHOULD CONTACT A LOCATOR SERVICE PRIOR TO ANY EXCAVATION

White Copy – Environmental Health YELLOW COPY (Final) Owner / Applicant PINK COPY (Initial) Owner / Applicant