IREDELL COUNTY HEALTH DEPARTMENT

Statesville Office (704) 878-5305 Mooresville Office (704) 660-3625 PERMIT # 216961

IMPROVEMENT PERMIT / AUTHORIZATION TO CONSTRUCT / OPERATION PERMIT / EXISTING SYSTEM

PIN # 4759156655 ✓

APPLICANT: Wayne Elledge APPLICANT ADDRESS: 234 Josey Rd Statesville NC

SITE ADDRESS: 112 Sunshine Farm Ln Statesville NC PHONE: 704-881-3464 ALT. PHONE: 704-881-8669

SITE DIRECTIONS: 77 N to Tomlin Mill Rd to Josey Rd Lot on right

SUBDIVISION: N/A SECTION: N/A LOT # N/A LOT AREA: 3.25ac DESIGN FLOW: 360 L.T.A.R.: 0.275


Septic Tank	1000 (gal)	STB	1012	Date	3/4/16	☑ New System	☐ Repair	☐ Expansion	System Type: I II ☒ III IV V VI	☒ Residence	No. Bedrooms 3
Pump Tank	1000 (gal)	PT	17	Date	3/14/16	System Description:			25% Reduction	☐ Business	No. Persons 6
Pump Make	Myers	Model	ME150	Serial #		Repair System Description:			TSD Drip	☐ Other	No. Employees
# Nitrification Fields	1	# Lines	3	Linear Ft:	330	Maintenance Agreement Required:	☐ YES	☒ NO		☐ Slab	☒ Crawl Space
Trench Width	36"	Max. Trench Bottom Depth	24"	Gravel Depth	N/A		☐ GRAVITY	☒ PRESSURE		☐ Basement w/plumbing	

Water Supply: ☐ Private ☒ Public ☐ Community

☐ Basement w/o plumbing

Comments / Conditions: Install 25% reduction with pressure distribution

INITIAL SITE SKETCH

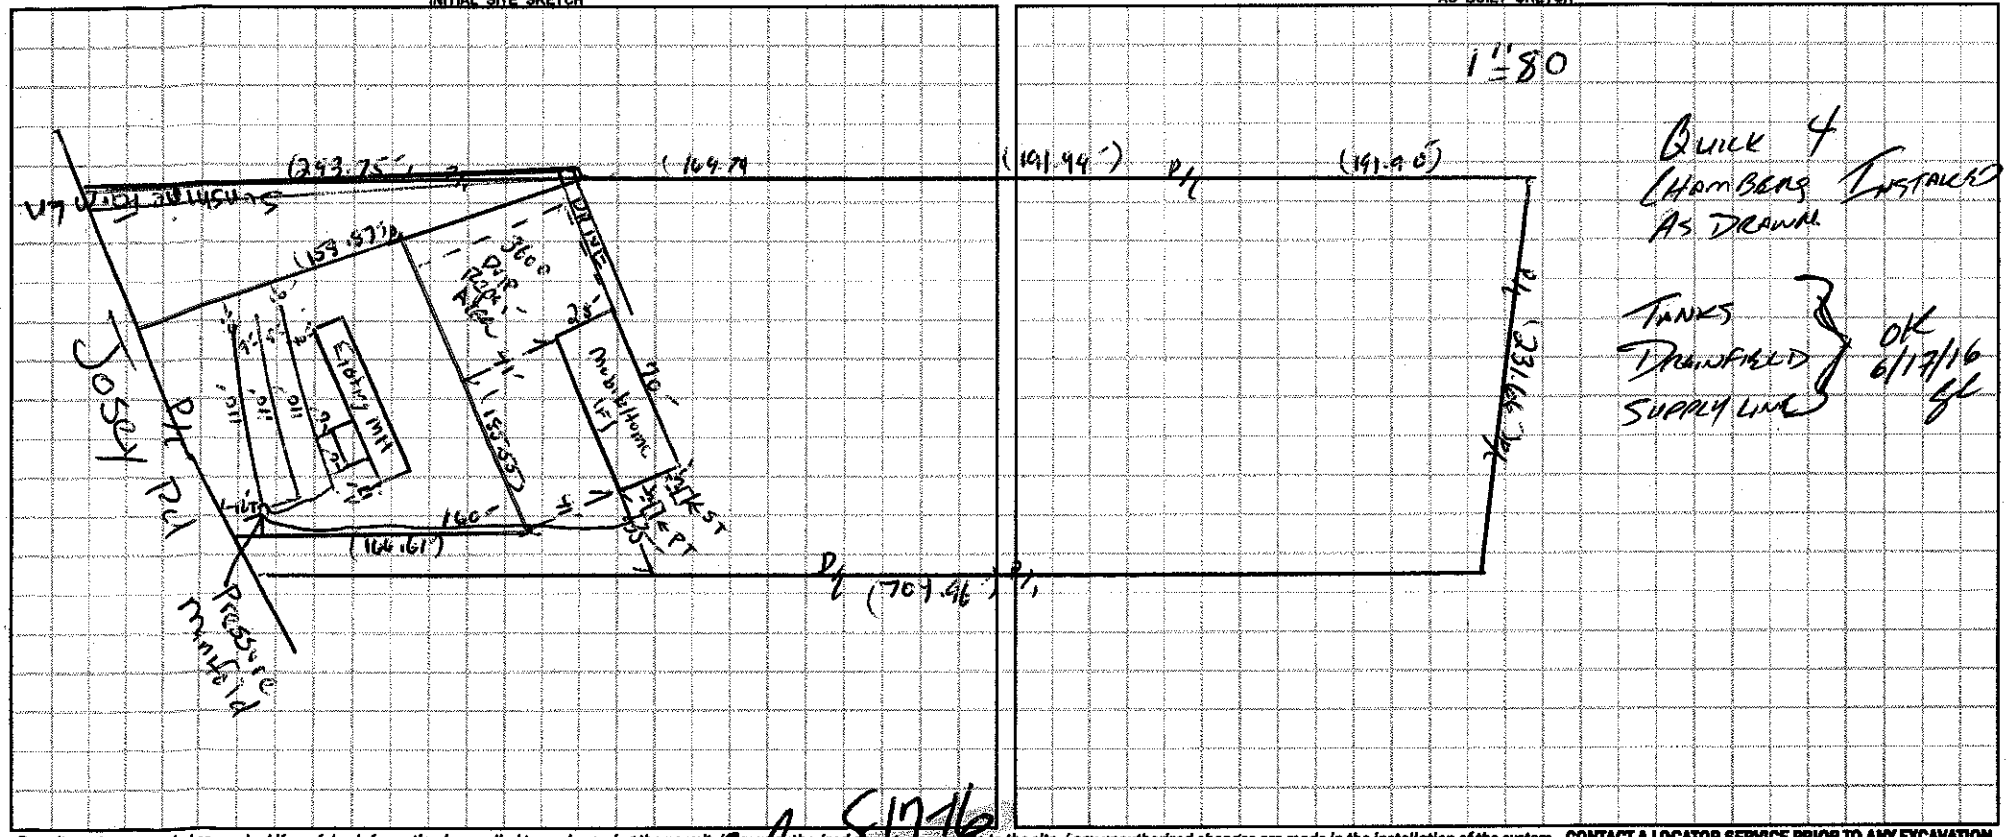

AS BUILT SKETCH

1"=80'

Quick 4 Chambers Installed As Drawn

Tanks
Drainfield
Supply Line

OK 6/17/16 SL

5/17/16

Permit can be suspended or revoked if any false information is supplied toward securing the permit / any unauthorized changes are made to the site / any unauthorized changes are made in the installation of the system. **CONTACT A LOCATOR SERVICE PRIOR TO ANY EXCAVATION**

☐ **IMPROVEMENT PERMIT** *with plat valid without expiration.* ☑ **IMPROVEMENT PERMIT** *with site plan valid for 60 mos.* ☑ **AUTHORIZATION TO CONSTRUCT** *valid for period equal to IMPROVEMENT PERMIT--not to exceed 60 mo.*

Owner / Applicant Signature: Wayne Elledge Date: 4-5-16 Installed by: Piedmont Backhoe

IMPROVEMENT PERMIT by: Date: 03/04/16 OPERATION PERMIT by: Date: 06/01/16

AUTHORIZATION TO CONSTRUCT by: Date: 05/16/15 Existing System Inspected by: Date:

Health Dept. Copy - WHITE Applicant (Final Approval) - YELLOW Applicant (Conditional Approval) - PINK