IREDELL COUNTY HEALTH DEPARTMENT

STATESVILLE 704-878-5305 MOORESVILLE 704-664-5281

IMPROVEMENT PERMIT / CERTIFICATE OF COMPLETION / OPERATION PERMIT / EXISTING SYSTEM INSPECTION

PROPERTY DESCRIPTION NO. REPAIR DATE 3/10/94 TAX MAP NO. REPAIR Watershed: ☐ Yes ☐ No

OWNER OR CONTRACTOR DR. RAY GREEN PHONE: Business Home 873-1436

ADDRESS 1216 DAVIE AV STVL NC 28677

LOCATION I-77 N, TR TOMLIN MILL, TL JOSEY TL COREY-DAW FARM RD HOUSE AT END

SUBDIVISION BLOCK / SECTION LOT LOT AREA 1 ACRE+ SITE CLASS. PS DESIGN FLOW 360 L.T.A.R. EXISTING

Septic Tank: EXISTING Gallons: STB Date

Pump Tank: Gallons: PT Date

Pump Make: Model Serial No.

Nitrification Field: No Fields 1 Square Feet 900 Linear Feet 300

No Lines 3 Trench Width 36" Max Trench Bottom Depth 18-36" Gravel Depth 12"

☐ New System ☑ Repair System Type: ☐ I ☐ II, IV, V, VI

System Description: CONV - GRAVITY

Repair System Description: CONV. GRAVITY

Maintenance Agreement Required: ☐ Yes ☑ No

☐ House/Mod. Home ☐ Mobile Home ☐ Business ☐ Other

No. Bedrooms 3 No. Bathrooms 2 No. Employees


☐ Slab ☐ Crawl Space ☐ Basement w/plumbing ☐ Basement wo/plumbing

Water Supply: ☑ Individual ☐ Community ☐ Public WELL


Comments: ① CHECK SEPTIC TANK FOR INTEGRITY, REPLACE SANITARY 'TEE' IF NECESSARY ② INSTALL NEW DROP BOXES AT LOCATION SHOWN ③ INSTALL NEW LINES AS SHOWN, ON CONTOUR, NO DEEPER THAN 36"

Comments: ④ TANK PUMPED OUT ⑤ NEW SANITARY TEE INSTALLED

INITIAL SITE SKETCH

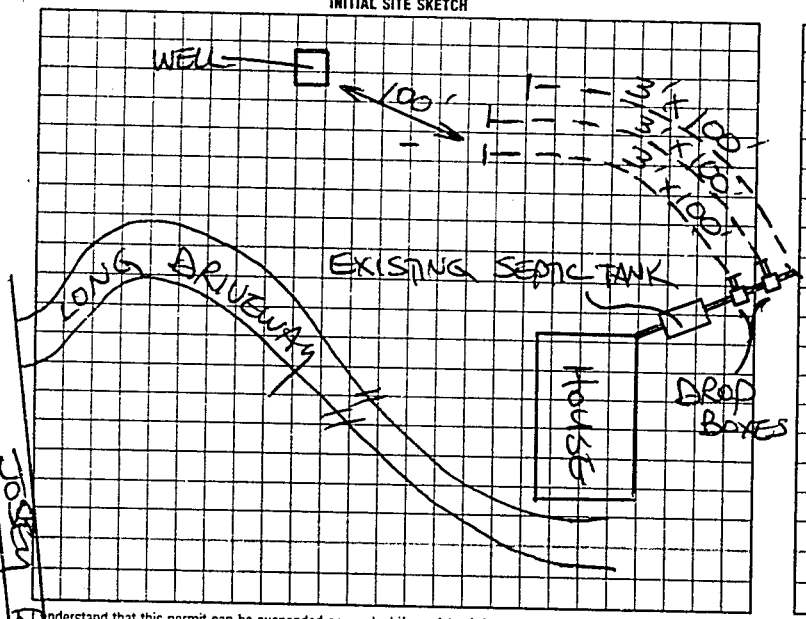

AS BUILT SKETCH

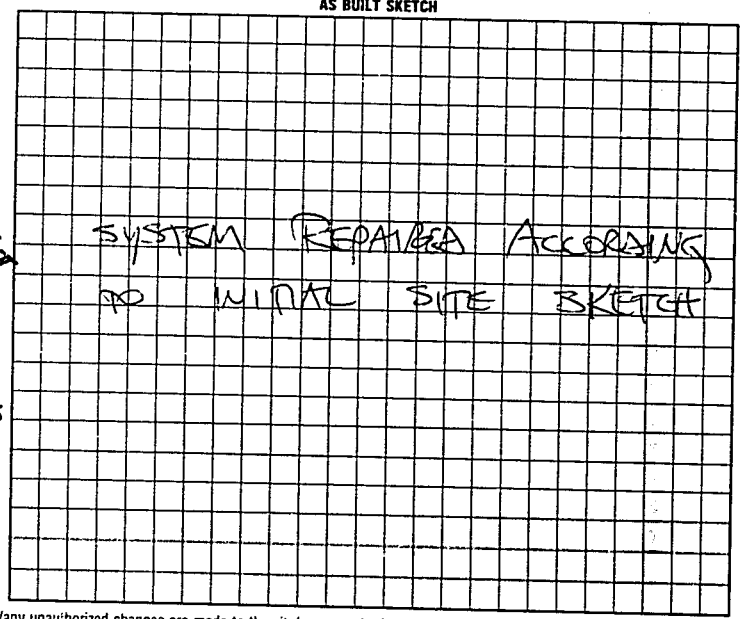

I understand that this permit can be suspended or revoked if any false information is supplied toward securing the permit/any unauthorized changes are made to the site/any unauthorized changes are made in the installation of the system. Improvement Permit is valid for 60 months from date of issuance.

Signed: X T. Steve Hedrick

Improvement Permit by: STEVE HEDRICK date 3/10/94

Existing System Inspection by: date

Installed by: A-1 BACKHOE

Certificate of Completion by: STEVE HEDRICK date 1/10/95

Operation Permit by: date

HEALTH DEPT. COPY. WHITE INSPECTION COPY (FINAL): GREEN OWNER COPY (FINAL): YELLOW INSPECTION COPY (INITIAL): PINK OWNER COPY (INITIAL): GOLD

117000