48888

IREDELL COUNTY HEALTH DEPARTMENT

STATESVILLE 704-878-5305 MOORESVILLE 704-664-5281

IMPROVEMENT PERMIT / CERTIFICATE OF COMPLETION / OPERATION PERMIT / EXISTING SYSTEM INSPECTION

PROPERTY DESCRIPTION NO. 16996 DATE 9/13/93 TAX MAP NO. 13H-A-27

OWNER OR CONTRACTOR ROY CHURCH PHONE: Business Home

ADDRESS RT-5 BOX 311 STATESVILLE, NC 28677

LOCATION I-77N, TR TOMLIN MILL RD, 1ST MH ON (L) SITE CLASS. PS L.T.A.R. 0.336 GPD/FT²

SUBDIVISION BLOCK / SECTION LOT LOT AREA

Water Supply: ☒ Individual ☐ Community ☐ Public

Septic Tank: 1000 Gallons; STB 358 Date 8/11/93

Pump Tank: Gallons; PT Date

Nitrification Field: No. Fields 1 Square Feet 720 Linear Feet 240

No. Lines 2 Trench Width 36" Trench Depth 18-36" Gravel Depth 12"

☒ New System ☐ Repair System Type: I, II, III, IV, V, VI

System Description: CONV. GRAVITY

Repair System Description: CONV. GRAVITY

Maintenance Agreement Required: ☐ Yes ☒ No

☐ House/Mod. Home ☒ Mobile Home ☐ Business ☐ Other

No. Bedrooms 2 No. Bathrooms 2 No. Employees

☐ Slab ☒ Crawl Space ☐ Basement w/plumbing ☐ Basement wo/plumbing

Garbage Disposal: ☐ Yes ☒ No


Auto. Dishwasher: ☒ Yes ☐ No

Auto. Washing Machine: ☒ Yes ☐ No


Other

Comments ① KEEP SYSTEM MINIMUM 5' FROM MH, 10' FROM PROPERTY LINE, 100' FROM WELL ② INSTALL LINES ON CONTOUR, No 1 DEEPER THAN 36", 9' APART ON CENTER.

INITIAL SITE SKETCH

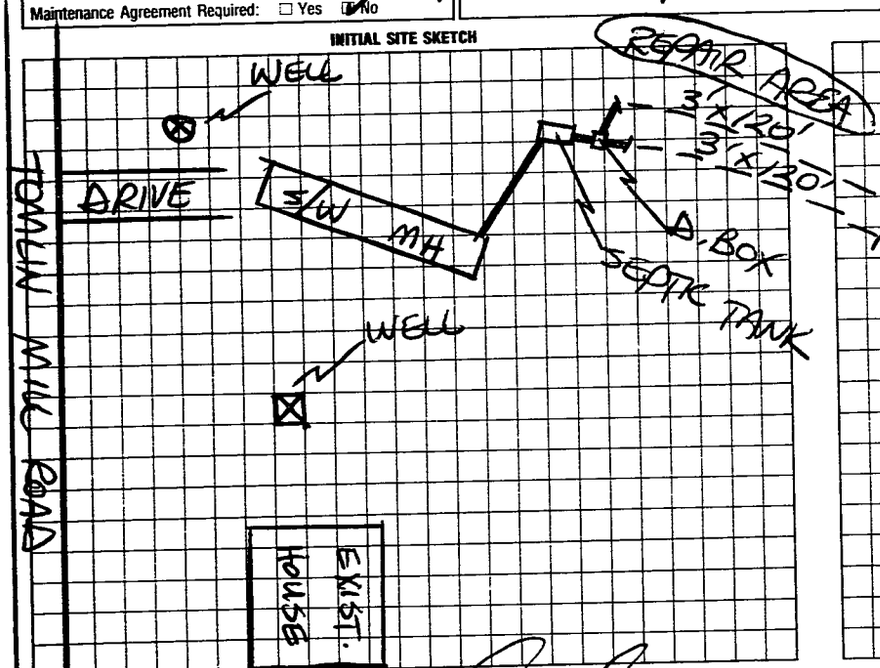

AS BUILT SKETCH

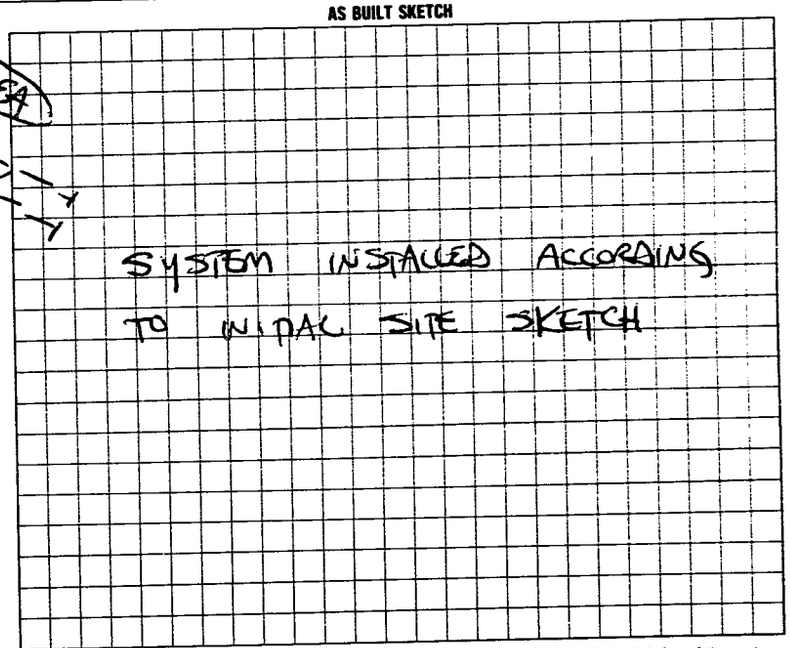

I understand that the permit can be suspended or revoked if any false information is supplied toward securing the permit/any unauthorized changes are made to the site/any unauthorized changes are made in the installation of the system. Improvement Permit is valid for 60 months from date of issuance.

Signed:

Improvement Permit by: STEVE HEDRICK date 9/13/93

Existing System Inspection by: date

Installed by: A-1 BACKHOE

Certificate of Completion by: STEVE HEDRICK date 9/24/93

Operation Permit by: date

HEALTH DEPT. COPY: WHITE INSPECTION COPY (FINAL): GREEN OWNER COPY (FINAL): YELLOW INSPECTION COPY (INITIAL): PINK OWNER COPY (INITIAL): GOLD

J