IREDELL COUNTY HEALTH DEPARTMENT

STATESVILLE 704-878-5305 MOORESVILLE 704-664-5281

IMPROVEMENT PERMIT / AUTHORIZATION TO CONSTRUCT / OPERATION PERMIT / EXISTING SYSTEM INSPECTION

PERMIT# 071028 PIN# 4759253793

OWNER OR CONTRACTOR Sandra Burr DATE 1-6-98

ADDRESS 153 Sandra Dr. Statesville PHONE: Business Home

LOCATION I-77N TR Tomlin Mill TL Josey TR Sandra 1st on left after Bend

SUBDIVISION BLOCK / SECTION LOT LOT AREA SITE CLASS. P/S DESIGN FLOW 360 L.T.A.R. 0.3

Septic Tank: Existing Gallons; STB Date

Pump Tank: Gallons; PT Date

Pump Make: Model Serial No.

Nitrification Field: No Fields 1 Square Feet 480 Linear Feet 160

No Lines 2 Trench Width 36in Max Trench Bottom Depth 36in Gravel Depth 12in

☒ New System ☐ Repair System Type: I, II, III, IV, V, VI

System Description: Gravity Conventional

Repair System Description: ~~Gravity~~ / Pump?

Maintenance Agreement Required: ☐ Yes ☒ No

☐ House/Mod. Home ☒ Mobile Home ☐ Business ☐ Other

No. Bedrooms 3 No. Bathrooms 2 No. Employees


Water Supply: ☒ Individual ☐ Public ☐ Community

☐ Slab ☒ Crawl Space ☐ Basement w/plumbing ☐ Basement wo/plumbing


Comments:/Conditions: Replacing 2Bd S/W with 3Bd D/W
Keep lines on contour 9ft on center
Need to Landscape - Fill in Gulleyes to keep surface Drainage over system

Comments:/Conditions:

INITIAL SITE SKETCH

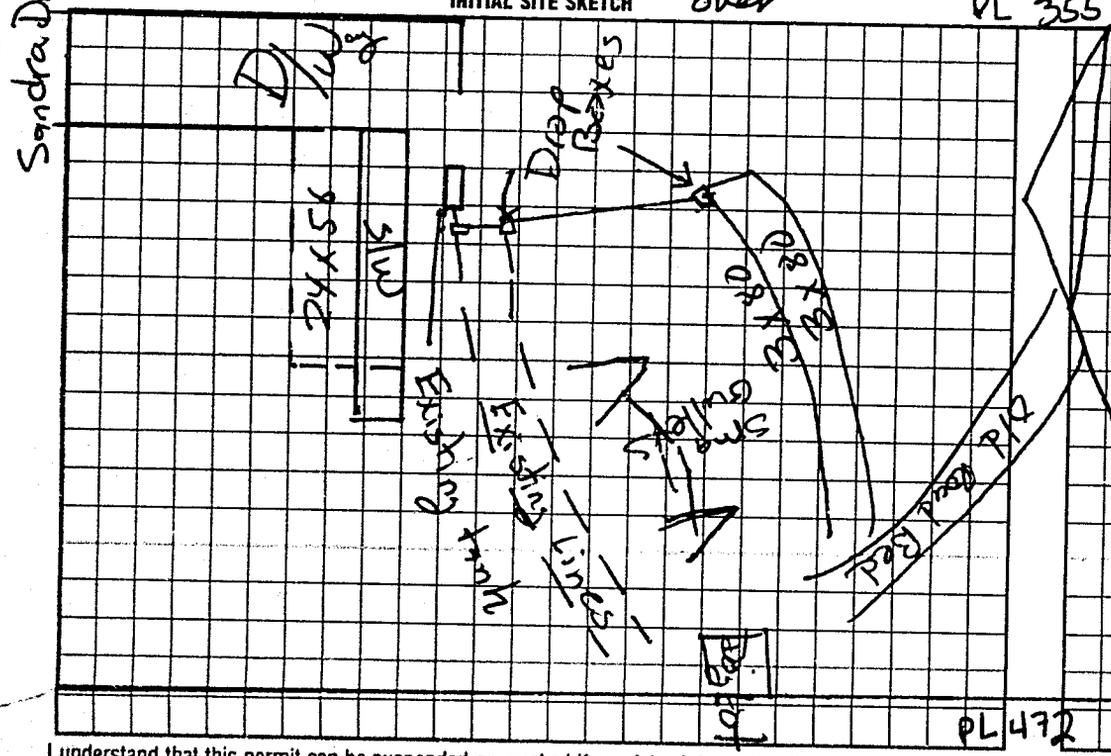

AS BUILT SKETCH

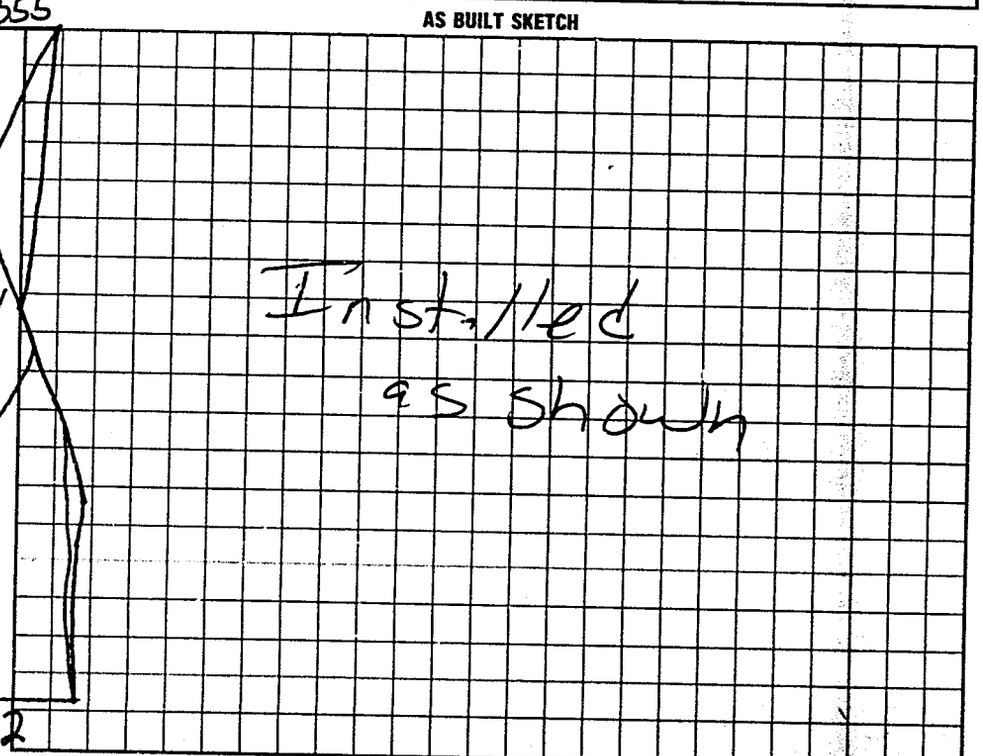

I understand that this permit can be suspended or revoked if any false information is supplied toward securing the permit/any unauthorized changes are made to the site/any unauthorized changes are made in the installation of the system. Improvement Permit with plat valid without expiration. Improvement Permit with site plan valid for sixty months. Authorization to Construct is valid for a period equal to that of Improvement Permit – not to exceed sixty months.

Signed: date

Improvement Permit by: Mark Coats RS date 1-6-98

Authorization to Construct by: Mark Coats RS date 1-6-98

Installed by: A-1 Backhoe

Operation Permit by: date

Existing System Inspection by: Mark Coats date 1-12-98

HEALTH DEPT. COPY: WHITE INSPECTION COPY (FINAL): GREEN OWNER COPY (FINAL): YELLOW INSPECTION COPY (INITIAL): PINK OWNER COPY (INITIAL): GOLD