IREDELL COUNTY HEALTH DEPARTMENT

STATESVILLE 704-878-5305 MOORESVILLE 704-664-5281

IMPROVEMENT PERMIT / AUTHORIZATION TO CONSTRUCT / OPERATION PERMIT / EXISTING SYSTEM INSPECTION

PERMIT# 103723 PIN# 4759-25-5761 DATE 12-21-01

OWNER OR CONTRACTOR JAMES WINEBARGER PHONE: Business _____ Home (704) 876-0822

ADDRESS 175 SANDRA DRIVE, STATESVILLE, NC 28625

LOCATION I-77 N, TR TOMLIN MILL RD, TL JOSEY RD, TR SANDRA DR, LOT ON LEFT BEHIND EXISTING

SUBDIVISION _____ BLOCK / SECTION _____ LOT _____ LOT AREA ~1.0 ACRE SITE CLASS PS DESIGN FLOW 360 L.T.A.R. 0.30 GPD/FT² S/W

Septic Tank: 1000 Gallons; STB 1012 Date 9-30-01

Pump Tank: _____ Gallons; PT _____ Date _____

Pump Make: _____ Model _____ Serial No. _____

Nitrification Field: No Fields 1 Square Feet 1200 Linear Feet 400

No Lines FIVE Trench Width 36" Max Trench Bottom Depth 36" Gravel Depth 12"

✔ New System ☐ Repair System Type: ☐ I ☐ II ☐ IV ☐ V ☐ VI

System Description: CONVENTIONAL GRAVITY

Repair System Description: 25% REDUCTION GRAVITY

Maintenance Agreement Required: ☐ Yes ✔ No

✔ House/Mod. Home No. Bedrooms 3

✔ Mobile Home No. Bathrooms 2

☐ Business No. Employees _____

☐ Other _____


Slab ✔ Crawl Space ☐ Basement w/plumbing ☐ Basement wo/plumbing

Water Supply: ✔ Individual ☐ Public ☐ Community WELL


Comments/Conditions: KEEP SYSTEM MINIMUM 100 FEET FROM WELL

Comments/Conditions: SEPTIC TANK WITH MARKER INSTALLED USING "POLYLOK" FILTER

INITIAL SITE SKETCH

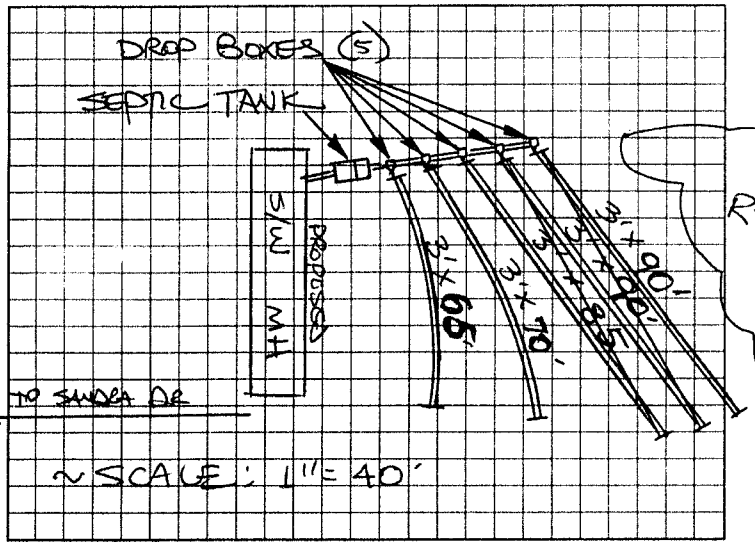

AS BUILT SKETCH

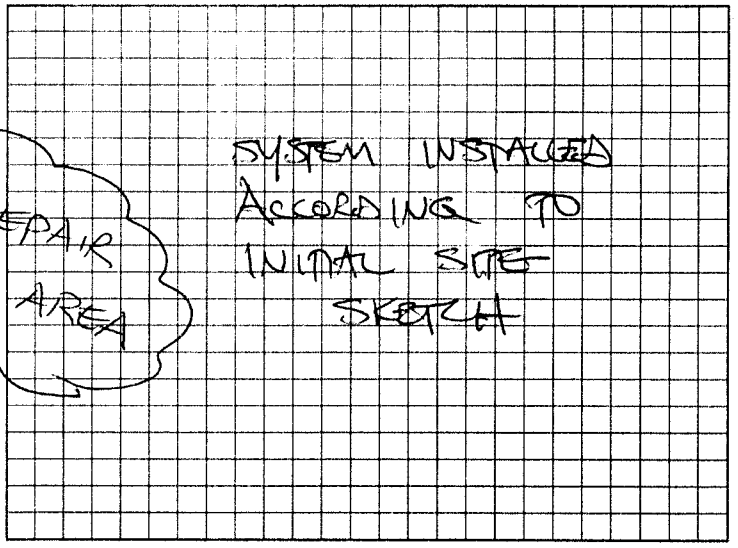

Permit can be suspended or revoked if any false information is supplied toward securing the permit/any unauthorized changes are made to the site/any unauthorized changes are made in the installation of the system. Improvement Permit with plat valid without expiration. Improvement Permit with site plan valid for sixty months. Authorization to Construct is valid for a period equal to that of Improvement Permit – not to exceed sixty months.

Signed: James Wineberger date 12-21-2001 Installed by: A-1 BACKHOE

Improvement Permit by: STEVE HEDRICK date 12-21-01 Operation Permit by: STEVE HEDRICK date 1-17-02

Authorization to Construct by: STEVE HEDRICK date 12-21-01 Existing System Inspection by: _____ date _____

HEALTH DEPT COPY: WHITE OWNER COPY (FINAL): YELLOW OWNER COPY (INITIAL): PINK