IREDELL COUNTY HEALTH DEPARTMENT

STATESVILLE 704-878-5305 MOORESVILLE 704-664-5281

IMPROVEMENT PERMIT / CERTIFICATE OF COMPLETION / OPERATION PERMIT / EXISTING SYSTEM INSPECTION

PROPERTY DESCRIPTION NO. _____ DATE 4-23-97 TAX MAP NO. _____ Watershed: ☐ Yes ☐ No

OWNER OR CONTRACTOR Mac Church PHONE: Business _____ Home 876 4042

ADDRESS 477 Fairmont

LOCATION I-77 N TR Tomlin Mill TR Fairmont 1/2 mi Rt.

SUBDIVISION _____ BLOCK / SECTION _____ LOT _____ LOT AREA 1.4 acres SITE CLASS. PS DESIGN FLOW 360 L.T.A.R. .36

Septic Tank: 1000 Gallons; STB _____ Date _____

Pump Tank: _____ Gallons; PT _____ Date _____

Pump Make: _____ Model _____ Serial No. _____

Nitrification Field: No Fields 1 Square Feet 960 Linear Feet 320

No Lines 4 Trench Width 36" Max Trench Bottom Depth 36" Gravel Depth 12"

☐ New System ☑ Repair System Type: I (II) III, IV, V, VI

System Description: _____

Repair System Description: Conv. Gravity

Maintenance Agreement Required: ☐ Yes ☐ No

☐ Slab ☑ Crawl Space ☐ Basement w/plumbing ☐ Basement wo/plumbing

☑ House/Mod. Home No. Bedrooms 3

☐ Mobile Home No. Bathrooms 2

☐ Business No. Employees _____

☐ Other _____


Water Supply:
☐ Individual
☐ Community
☑ Public

Comments:


Discontinue use of old line connect to new Drainfield as shown

Comments:

INITIAL SITE SKETCH

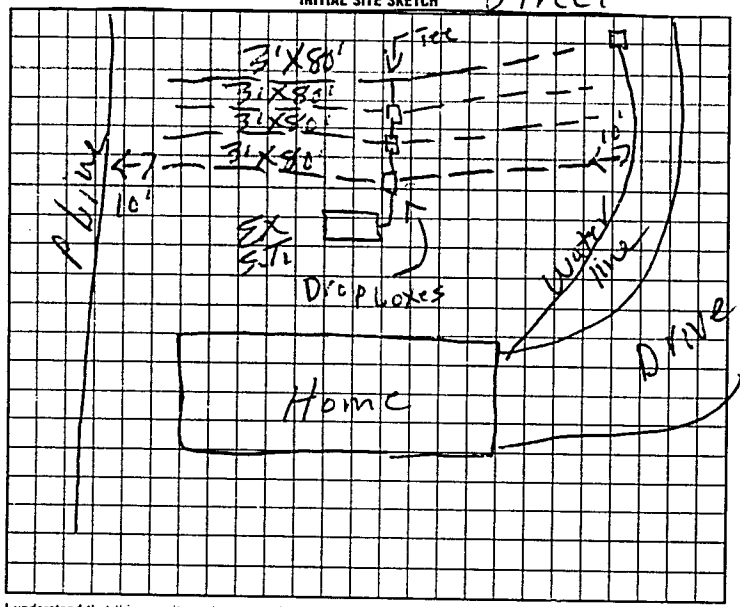

AS BUILT SKETCH

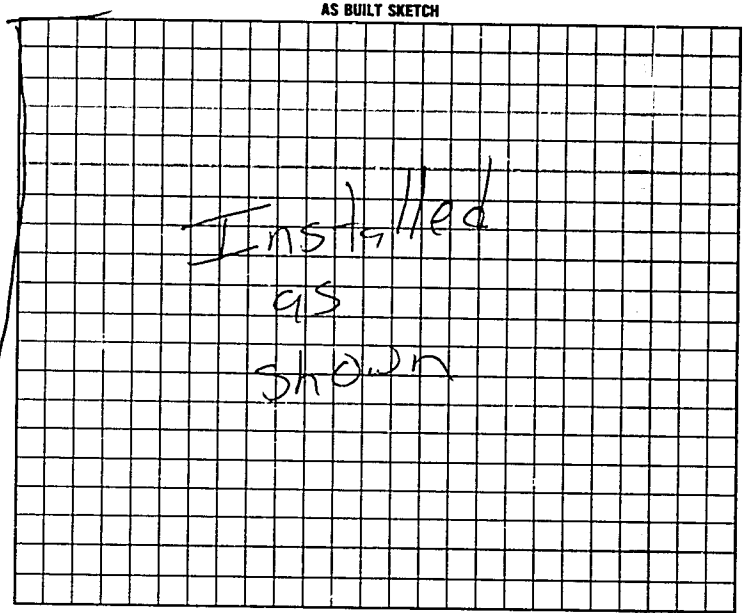

I understand that this permit can be suspended or revoked if any false information is supplied toward securing the permit/any unauthorized changes are made to the site/any unauthorized changes are made in the installation of the system. Improvement Permit is valid for 60 months from date of issuance.

Signed: Mac Church

Improvement Permit by: F.E. Moore date 4-23-97

Existing System Inspection by: F.E. Moore date 4-23-97

authorization to court

Installed by: A-1 Backhoe

Certificate of Completion by: _____ date _____

Operation Permit by: Mac Cathey date 5-9-97

HEALTH DEPT. COPY: WHITE INSPECTION COPY (FINAL): GREEN OWNER COPY (FINAL): YELLOW INSPECTION COPY (INITIAL): PINK OWNER COPY (INITIAL): GOLD

to Court. authorization to court EXPires 60 mos from issu

1 E 1 0 0 0