IREDELL COUNTY HEALTH DEPARTMENT

Statesville Office (704) 878-5305 Mooresville Office (704) 660-3625 PERMIT # 180308

IMPROVEMENT PERMIT / AUTHORIZATION TO CONSTRUCT / OPERATION PERMIT / EXISTING SYSTEM

PIN # 4759332195

APPLICANT: ~~Harold Lundy~~ STEVEN DOWDLE APPLICANT ADDRESS: ~~815~~ 835 Tomlin ~~Rd.~~ MILL ROAD

SITE ADDRESS: 835 Tomlin Mill Rd. PHONE: 704-902-7014 ALT. PHONE: N/A


SITE DIRECTIONS: I-77 N to Tomlin Mill Rd Exit TR Tomlin Mill, Property on Right

SUBDIVISION: N/A SECTION: N/A LOT # N/A LOT AREA: 1.12 DESIGN FLOW: 360gpd L.T.A.R.: 0.3

Septic Tank	1000 (gal)	STB	1012-1000	Date	5-23-13	☑ New System	☐ Repair	☐ Expansion	System Type: I II ☒ IV V VI	☑ Residence	No. Bedrooms 3	Water Supply
Pump Tank	(gal)	PT		Date		System Description:	25% Reduction			☐ Business	No. Persons	☐ Private
Pump Make		Model		Serial #		Repair System Description:	25% Reduction – Pump			☐ Other	No. Employees	☑ Public
# Nitrification Fields	1	# Lines	3	Linear Ft:	300	Maintenance Agreement Required:	☐ YES	☑ NO		☐ Slab	☐ Crawl Space	☐ Community
Trench Width	36"	Max. Trench Bottom Depth	36"	Gravel Depth	N/A		☑ GRAVITY	☐ PRESSURE		☐ Basement w/plumbing	☑ Basement w/o plumbing	

Comments / Conditions: Install a 25% Reduction system on contour with serial distribution. It is recommended to divert all gutter drains & other surface water away from septic area.

INITIAL SITE SKETCH

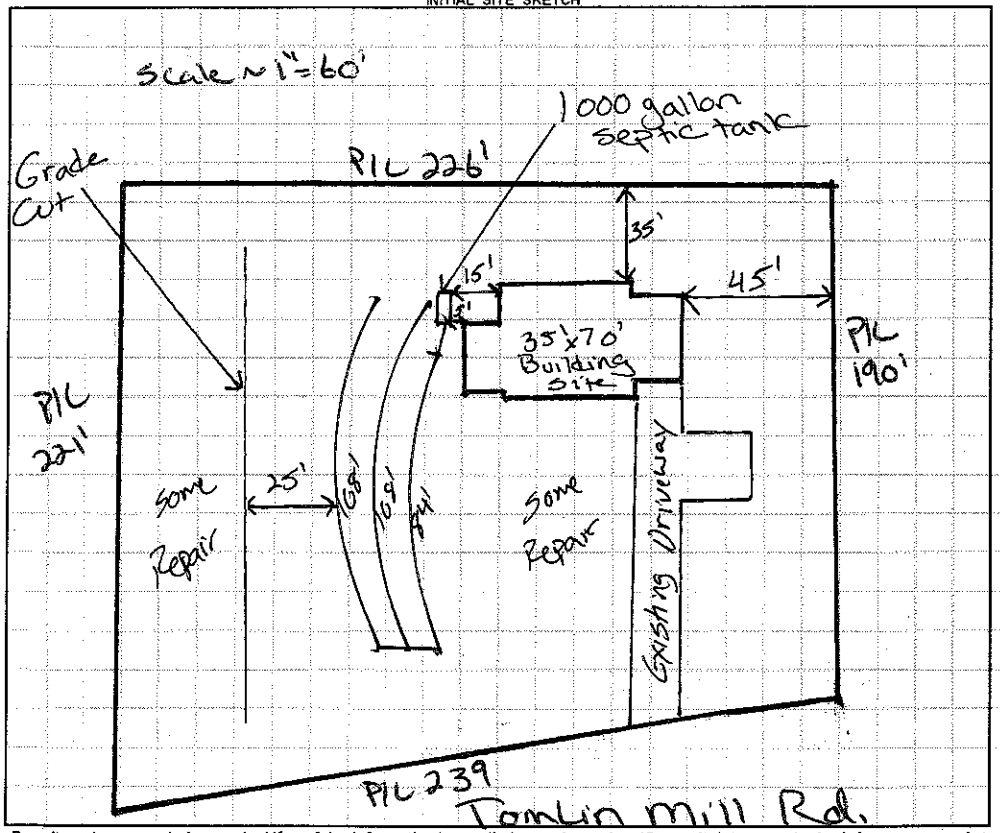

AS BUILT SKETCH

- 2" PVC Tank marker installed
- Red Poly filter installed
- Quick 4 chambers installed
- Installed as drawn

Permit can be suspended or revoked if any false information is supplied toward securing the permit / any unauthorized changes are made to the site / any unauthorized changes are made in the installation of the system. **CONTACT A LOCATOR SERVICE PRIOR TO ANY EXCAVATION**

☐ **IMPROVEMENT PERMIT** *with plat valid without expiration.* ☐ **IMPROVEMENT PERMIT** *with site plan valid for 60 mos.* ☑ **AUTHORIZATION TO CONSTRUCT** *valid for period equal to IMPROVEMENT PERMIT--not to exceed 60 mo.*

Owner / Applicant Signature: Kayna C Dowdle Date: 9/10/13 Installed by: Steve Jordan

IMPROVEMENT PERMIT by: Justin Henderson Date: 8-19-13 OPERATION PERMIT by: Justin Henderson Date: 11-25-13

AUTHORIZATION TO CONSTRUCT by: Justin Henderson Date: 8-19-13 Existing System Inspected by: Date:

Health Dept. Copy - WHITE Applicant (Final Approval) - YELLOW Applicant (Conditional Approval) - PINK