IREDELL COUNTY HEALTH DEPARTMENT

STATESVILLE 704-878-5305 MOORESVILLE 704-664-5281

IMPROVEMENT PERMIT / CERTIFICATE OF COMPLETION / OPERATION PERMIT / EXISTING SYSTEM INSPECTION

PROPERTY DESCRIPTION NO. 17144 DATE 10/18/93

OWNER OR CONTRACTOR RALPH CHURCH TAX MAP NO. 13H-A-38 PART OF

ADDRESS RT-5, BOX 321 STATESVILLE, NC 28677 PHONE: Business 663-7923 Home

LOCATION I-77 N, TR TOMLIN MILL ROAD, TR FAIRMOUNT CH. RD, 1ST LOT ON (R)

SUBDIVISION BLOCK / SECTION LOT LOT AREA AMPLE SITE CLASS. PS L.T.A.R. 0.35 GPD/FT²

Water Supply: ☐ Individual ☐ Community ✓ Public

Septic Tank 1000 Gallons, STB 358 Date 12/21/93

Pump Tank: Gallons, PT Date

Nitrification Field: No. Fields 1 Square Feet 690 Linear Feet 230

No. Lines 3 Trench Width 36" Trench Depth 18-36" Gravel Depth 12"

✓ New System ☐ Repair System Type: (I) II, III, IV, V, VI

System Description: CONV. GRAVITY

Repair System Description: CONV. PUMP

Maintenance Agreement Required: ☐ Yes ✓ No

☐ House/Mod. Home ✓ Mobile Home ☐ Business ☐ Other

No. Bedrooms 2 No. Bathrooms 2 No. Employees

Garbage Disposal: ☐ Yes ☐ No

Auto. Dishwasher: ☐ Yes ☐ No


Auto. Washing Machine: ☐ Yes ☐ No

Other

☐ Slab ✓ Crawl Space ☐ Basement w/plumbing ☐ Basement wo/plumbing

Comments (1) APPROVED FOR 2 BR ONLY (2) KEEP SYSTEM MINIMUM 5' FROM MH, 10' FROM PROPERTY LINE (3) INSTALL LINES ON CONTOUR, NO DEEPER THAN 36", 9' APART ON CENTER.

INITIAL SITE SKETCH

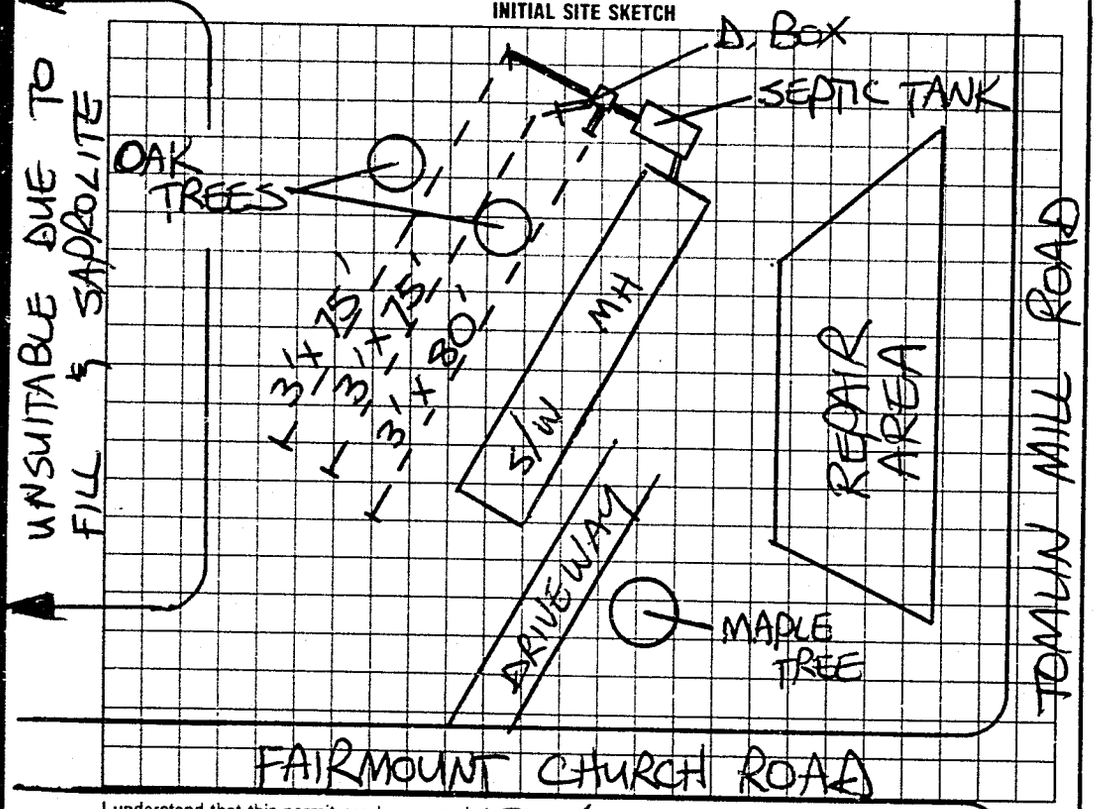

AS BUILT SKETCH

SYSTEM INSTALLED ACCORDING TO INITIAL SITE SKETCH

I understand that this permit can be suspended or revoked if any false information is supplied toward securing the permit/any unauthorized changes are made to the site/any unauthorized changes are made in the installation of the system. Improvement Permit is valid for 60 months from date of issuance.

Signed: X [signature]

Improvement Permit by: STEVE HEDRICK date 10/18/93

Existing System Inspection by: date

Installed by: A-1 BACKHOE

Certificate of Completion by: STEVE HEDRICK date 2/8/94

Operation Permit by: date

HEALTH DEPT. COPY WHITE INSPECTION COPY (FINAL) GREEN OWNER COPY (FINAL) YELLOW INSPECTION COPY (INITIAL) PINK OWNER COPY (INITIAL) GOLD