IREDELL COUNTY HEALTH DEPARTMENT

Statesville Office (704) 878-5305 Mooresville Office (704) 660-3625 PERMIT # 212009

IMPROVEMENT PERMIT / AUTHORIZATION TO CONSTRUCT / OPERATION PERMIT / EXISTING SYSTEM

PIN # 4759346332

APPLICANT: Scottie Driver APPLICANT ADDRESS: Po Box 72 Turnersburg NC

SITE ADDRESS: 802 Tomlin Mill Rd. PHONE: 704-682-0693 ALT. PHONE: N/A

SITE DIRECTIONS: Hwy 21N TL Farmount Rd TR Tomlin Mill Rd Property on Left


SUBDIVISION: N/A SECTION: N/A LOT # N/A LOT AREA: 5.06 acres DESIGN FLOW: 360gpd L.T.A.R.: 0.3

Septic Tank	1000 (gal)	STB	1012-1006	Date	4-13-15	☑ New System	☐ Repair	☐ Expansion	System Type: I II (III) IV V VI	☑ Residence	No. Bedrooms 3
Pump Tank	(gal)	PT		Date		System Description:	25% Reduction			☐ Business	No. Persons 6
Pump Make		Model		Serial #		Repair System Description:	25% Reduction			☐ Other	No. Employees
# Nitrification Fields	1	# Lines	3	Linear Ft:	300	Maintenance Agreement Required:	☐ YES	☑ NO		☐ Slab	☐ Crawl Space
Trench Width	36"	Max. Trench Bottom Depth	36"	Gravel Depth	N/A	☑ GRAVITY	☐ PRESSURE			☑ Basement w/plumbing	☑ Basement w/o plumbing

Water Supply: ☐ Private ☑ Public ☐ Community

Comments / Conditions: Install a 25% Reduction System on contour with serial distribution.
* Install trench bottoms @ 36" * *

INITIAL SITE SKETCH

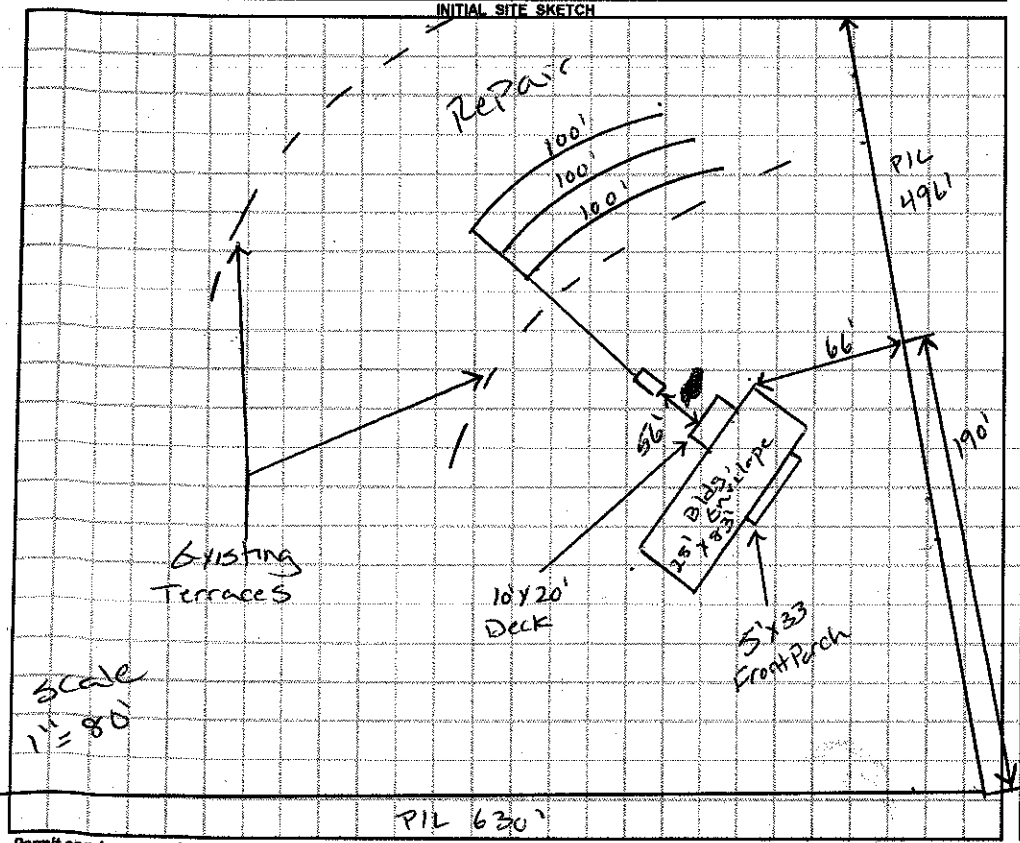

Scale 1" = 80'

AS BUILT SKETCH

- Yellow Tuf-tite filter installed
- 2" PVC ST meter
- Quick 4 Chambers installed as drawn
- Installed as drawn

Permit can be suspended or revoked if any false information is supplied toward securing the permit / any unauthorized changes are made to the site / any unauthorized changes are made in the installation of the system. **CONTACT A LOCATOR SERVICE PRIOR TO ANY EXCAVATION**

☐ **IMPROVEMENT PERMIT** *with plan valid without expiration.* ☑ **IMPROVEMENT PERMIT** *with site plan valid for 60 mos.* ☑ **AUTHORIZATION TO CONSTRUCT** *valid for period equal to IMPROVEMENT PERMIT--not to exceed 60 mo.*

Owner / Applicant Signature: [signature] Date: 7-24-15 Installed by: Steve Sordan

IMPROVEMENT PERMIT by: Justin Henderson Date: 7-24-15 OPERATION PERMIT by: Justin Henderson Date: 12-11-15

AUTHORIZATION TO CONSTRUCT by: Justin Henderson Date: 7-24-15 Existing System Inspected by: Date:

Health Dept. Copy - WHITE Applicant (Final Approval) - YELLOW Applicant (Conditional Approval) - PINK