49070

# IREDELL COUNTY HEALTH DEPARTMENT

STATESVILLE 704-878-5305 MOORESVILLE 704-664-5281

## IMPROVEMENT PERMIT / CERTIFICATE OF COMPLETION / OPERATION PERMIT / EXISTING SYSTEM INSPECTION

PROPERTY DESCRIPTION NO. 17249 DATE 10/13/93 TAX MAP NO. PART OF 13H-A-12A

OWNER OR CONTRACTOR HERITAGE BLDG. CO. PHONE: Business 528-6644 Home

ADDRESS RT. 10, BOX 177-A, STVL, NC 28677

LOCATION I-77 N, TR TOMLIN MILL RD, TL JOSEY RD, ~ 0.75 MI ON (R) JUST BEFORE PATTERSON CREEK

SUBDIVISION BLOCK / SECTION LOT LOT AREA 2.204 AC. SITE CLASS. PS L.T.A.R. 0.33 GPD/FT2

Water Supply: ☑ Individual ☐ Community ☐ Public WELL TO BE LOCATED

Septic Tank: 1000 Gallons; STB 794 Date 10/5/93

Pump Tank: Gallons; PT Date

Nitrification Field: No Fields 1 Square Feet 1080 Linear Feet 360

No Lines 3 Trench Width 36" Trench Depth 18-36 Gravel Depth 12"

☑ New System ☐ Repair System Type: I (II, III, IV, V, VI)

System Description: CONV. GRAVITY

Repair System Description: CONV. GRAVITY

Maintenance Agreement Required: ☐ Yes ☑ No

☐ House/Mod. Home ☐ Mobile Home ☐ Business ☐ Other

No. Bedrooms 3 No. Bathrooms 2 No. Employees

Garbage Disposal: ☐ Yes ☑ No

Auto. Dishwasher: ☑ Yes ☐ No


Auto. Washing Machine: ☑ Yes ☐ No

Other


☐ Slab ☑ Crawl Space ☐ Basement w/plumbing ☐ Basement wo/plumbing

Comments (1) KEEP SYSTEM MINIMUM 5' FROM HOUSE, 10' FROM PROPERTY LINE, 100' FROM WELL (2) INSTALL LINES ON CONTOUR, NO DEEPER THAN 36", 9' APART ON CENTER

**INITIAL SITE SKETCH**

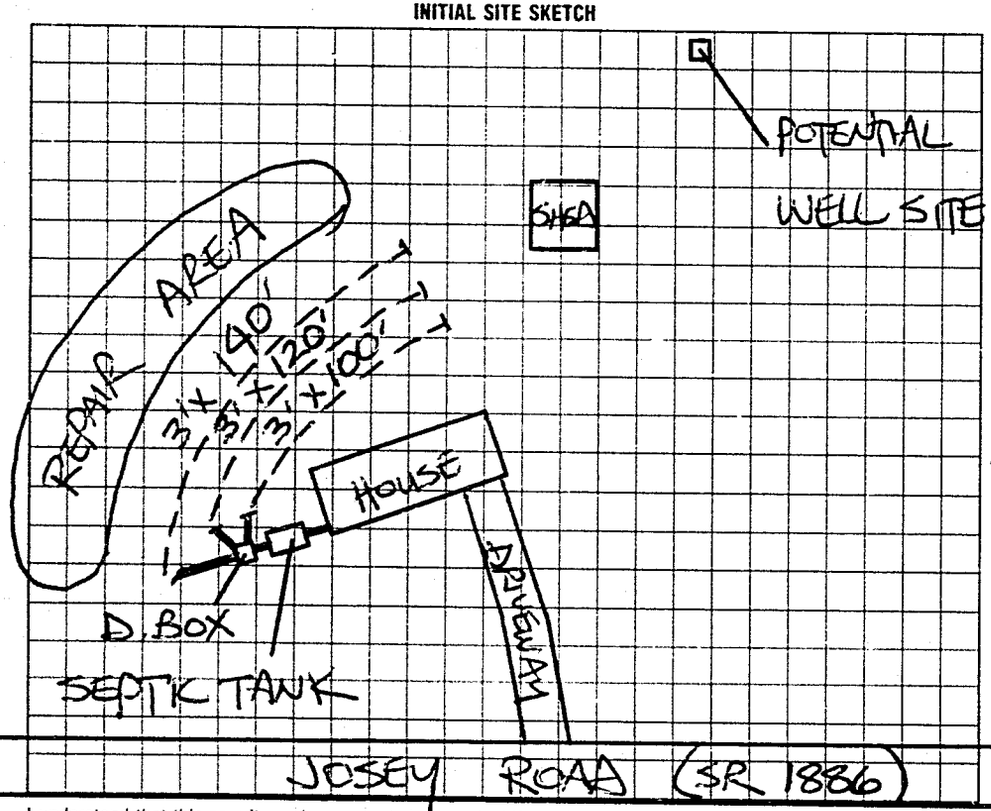


**AS BUILT SKETCH**

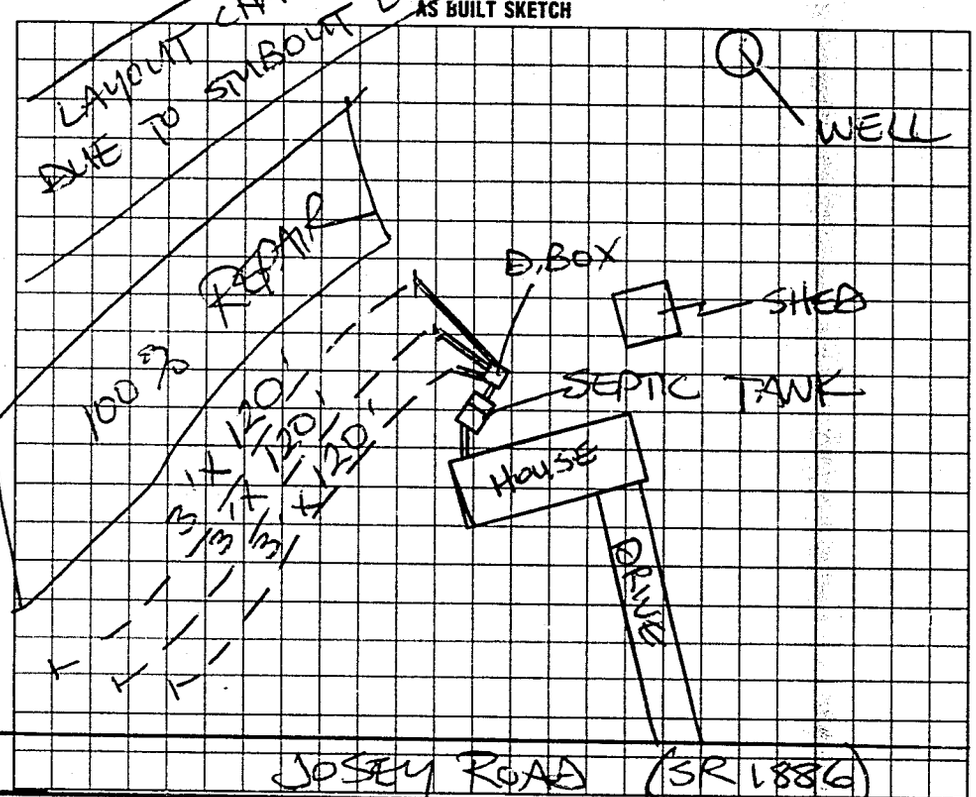


I understand that this permit can be suspended or revoked if any false information is supplied toward securing the permit/any unauthorized changes are made to the site/any unauthorized changes are made in the installation of the system. Improvement Permit is valid for 60 months from date of issuance.

Signed: Steve Hedrick

Improvement Permit by: STEVE HEDRICK date 10/13/93

Existing System Inspection by: date

Installed by: WES LYTTON

Certificate of Completion by: STEVE HEDRICK date 1/6/94

Operation Permit by: date

HEALTH DEPT. COPY WHITE INSPECTION COPY (FINAL) GREEN OWNER COPY (FINAL) YELLOW INSPECTION COPY (INITIAL) PINK OWNER COPY (INITIAL) GOLD