IREDELL COUNTY HEALTH DEPARTMENT

STATESVILLE 704-878-5305 MOORESVILLE 704-664-5281

IMPROVEMENT PERMIT / AUTHORIZATION TO CONSTRUCT / OPERATION PERMIT / EXISTING SYSTEM INSPECTION

PERMIT # 158502 PIN # 4759 40 02 411606 DATE 11-20-09

OWNER or APPLICANT Ralph Cline PHONE: Business Home: 701-872-8672

OWNER or APPLICANT ADDRESS 567 Fairmont Road Statesville

LOCATION / DIRECTIONS 77 N exit 59 R Tomlinson R Fairmont 482 Fairmont

SUBDIVISION BLOCK / SECTION LOT # LOT AREA 1.508 DESIGN FLOW 360 L.T.A.R. .25

Septic Tank 1000 Gallons: STB 1000 Date 12-7-09

Pump Tank Gallons: P T Date

Pump Make Model Serial #

Nitrification Field No Fields No Lines Linear Feet 360

Trench Width 36" Max. Trench Bottom Depth 36" Gravel Depth N/F

☑ New System ☐ Repair ☐ Expansion System Type I II III IV V VI

System Description: 25% Conv.

Repair System Description: 50% Low Pressure

Maintenance Agreement Required ☐ YES ☑ NO

☑ GRAVITY ☐ PRESSURE

☑ Residence No. Bedrooms 3 ☐ Business No. Persons ☐ Other No. Employees ☐ Slab ☐ Crawl Space ☐ Basement w/plumbing ☐ Basement w/o plumbing


Water Supply: ☐ Private ☑ Public ☐ Community

Comments / Conditions


Comments / Conditions

Upstairs on Bottom
Maintain all setbacks

INITIAL SITE SKETCH

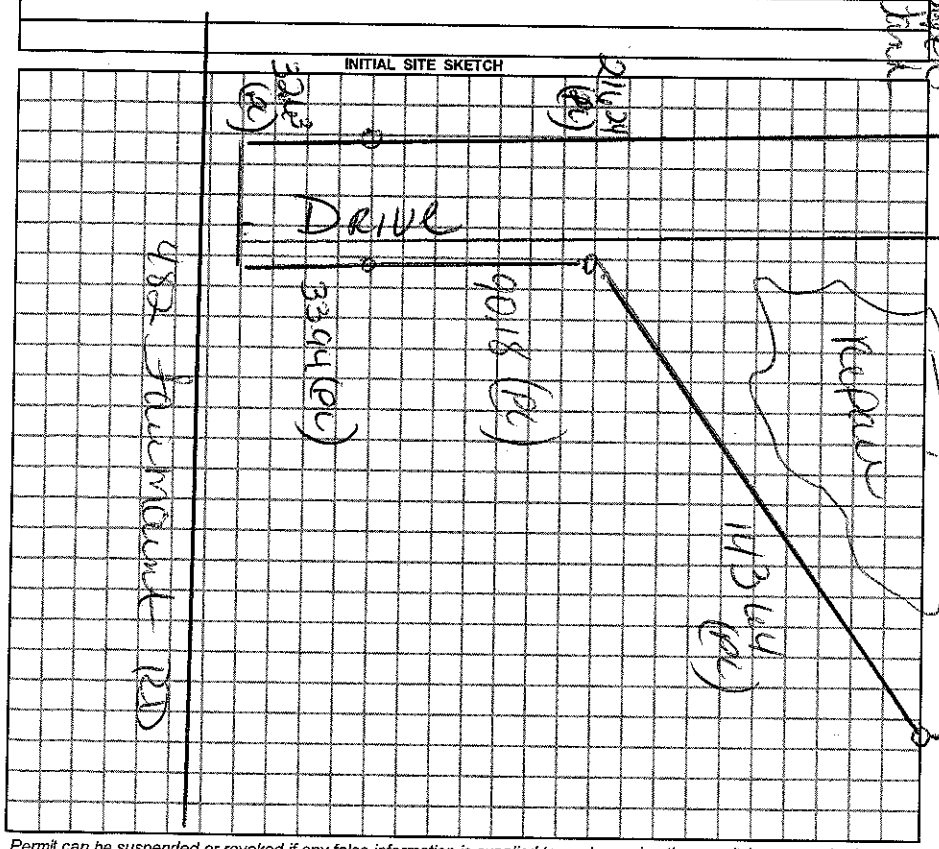

AS BUILT SKETCH

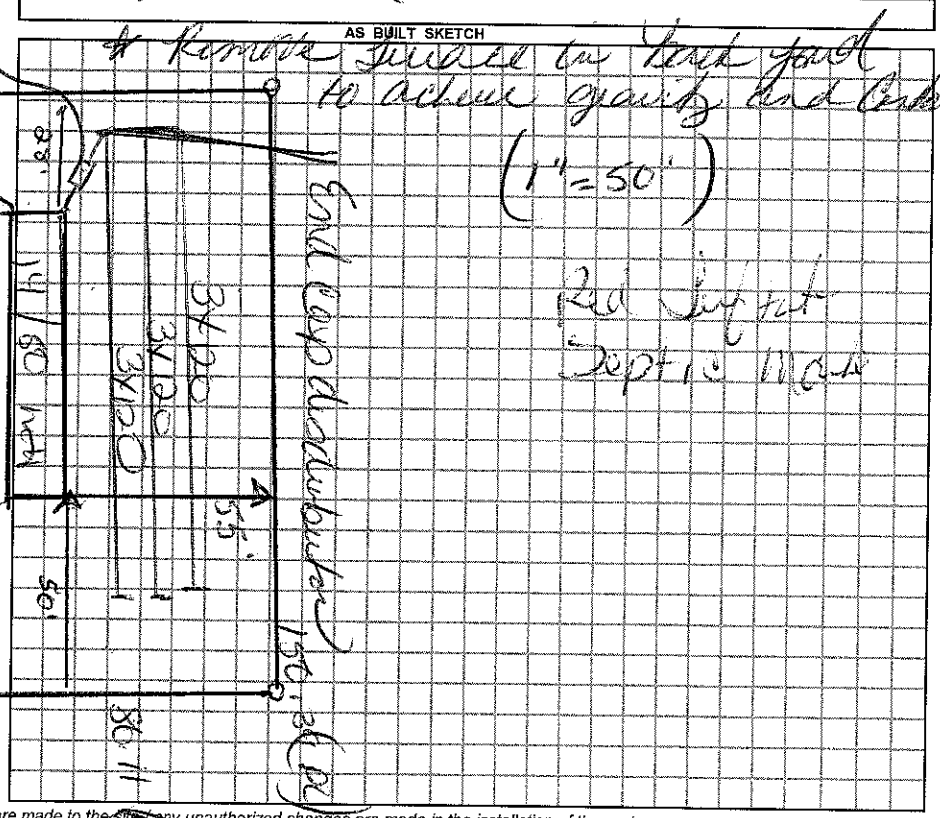

* Remove Gravel in front yard to achieve yard and Grade (1"=50')

Permit can be suspended or revoked if any false information is supplied toward securing the permit / any unauthorized changes are made to the site / any unauthorized changes are made in the installation of the system.

☐ IMPROVEMENT PERMIT w / plat valid without expiration. ☑ IMPROVEMENT PERMIT w / site plan valid for 60 mos. ☑ AUTHORIZATION TO CONSTRUCT valid for period equal to IMPROVEMENT PERMIT-not to exceed 60 mo.

Owner / Applicant Signature: Date 12-14-09

Improvement Permit by: Date 11-20-09

Authorization to Construct by: Date 11-20-09

YOU SHOULD CONTACT A LOCATOR SERVICE PRIOR TO ANY EXCAVATION.

Installed by: Date:

Operation Permit by: Date: 12-17-09

Existing System Inspected by: Date:

WHITE COPY Environmental Health YELLOW COPY (Final) Owner / Applicant PINK COPY (Initial) Owner / Applicant