IREDELL COUNTY HEALTH DEPARTMENT

STATESVILLE 704-878-5305 MOORESVILLE 704-664-5281

IMPROVEMENT PERMIT / AUTHORIZATION TO CONSTRUCT / OPERATION PERMIT / EXISTING SYSTEM INSPECTION

PERMIT# 076650 PIN# 4759 42 5244 DATE 3-9-99

OWNER OR CONTRACTOR James Hayes PHONE: Business _____ Home _____

ADDRESS 516 Fairmount Rd Statesville, N.C.

LOCATION 77 N TR Tomlin Mill TR Fairmount lot on Left in Curve

SUBDIVISION _____ BLOCK / SECTION _____ LOT _____ LOT AREA 20,000 SITE CLASS _____ DESIGN FLOW 360 L.T.A.R. 0.5

Septic Tank: 1000 Gallons; STB _____ Date _____
Pump Tank: Enviro Gallons; PT _____ Date _____
Pump Make: _____ Model _____ Serial No. _____
Nitrification Field: No Fields ____ Square Feet _____ Linear Feet 240
No Lines _____ Trench Width _____ Max Trench Bottom Depth _____ Gravel Depth _____

☐ New System ☐ Repair System Type: I. II. III. IV. V. VI
System Description: _____
Repair System Description: _____
Maintenance Agreement Required: ☐ Yes ☐ No

☐ House/Mod. Home ☑ Mobile Home ☐ Business ☐ Other
No. Bedrooms 3 No. Bathrooms 2 No. Employees ____


☐ Slab ☑ Crawl Space ☐ Basement w/plumbing ☐ Basement wo/plumbing

Water Supply: ☐ Individual ☑ Public ☐ Community


Comments/Conditions:

Comments/Conditions:
Existing System check
keep Fabrics silt from system

INITIAL SITE SKETCH

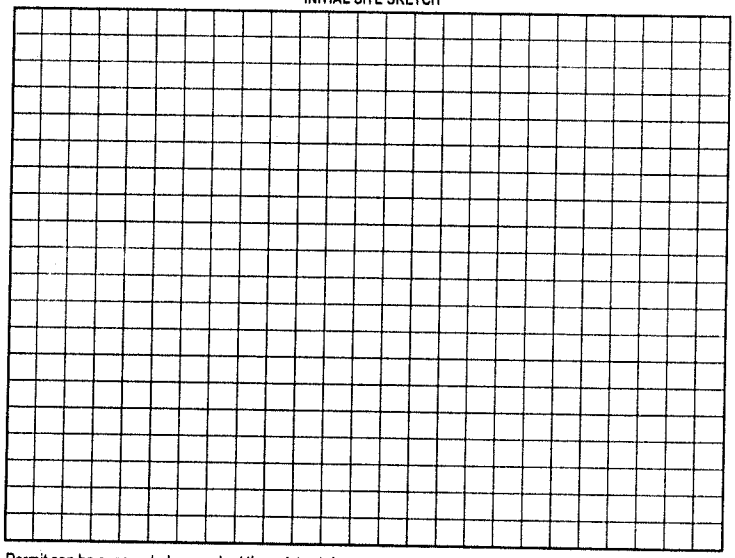

AS BUILT SKETCH

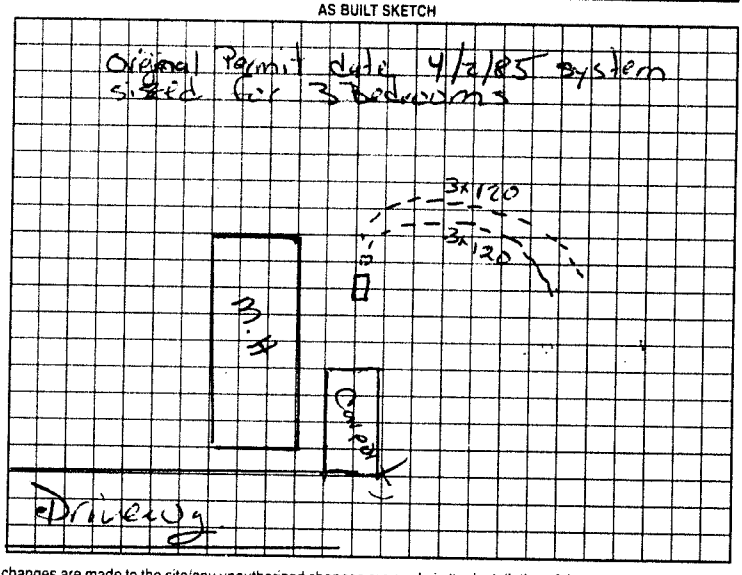

Permit can be suspended or revoked if any false information is supplied toward securing the permit/any unauthorized changes are made to the site/any unauthorized changes are made in the installation of the system. Improvement Permit with plat valid without expiration. Improvement Permit with site plan valid for sixty months. Authorization to Construct is valid for a period equal to that of Improvement Permit - not to exceed sixty months.

Signed: _____ date _____ Installed by: _____

Improvement Permit by: _____ date _____ Operation Permit by: _____ date _____

Authorization to Construct by: _____ date _____ Existing System Inspection by: [illegible] date 3-9-99

HEALTH DEPT. COPY: WHITE OWNER COPY (FINAL): YELLOW OWNER COPY (INITIAL): PINK