IREDELL COUNTY HEALTH DEPARTMENT SC STATESVILLE 704-878-5305 (ad) MOORESVILLE 704-664-5281

IMPROVEMENT PERMIT / AUTHORIZATION TO CONSTRUCT / OPERATION PERMIT / EXISTING SYSTEM INSPECTION

PERMIT # 152963 PIN # 4759-43-9326 DATE OCTOBER 15, 2008

OWNER or APPLICANT TIMOTHY BEST PHONE: Business 704-880-3503 Home: 704-876-0910

OWNER or APPLICANT ADDRESS 760 TOMLIN MILL ROAD, STATESVILLE, NC 28625

LOCATION / DIRECTIONS I-77 NORTH, TR TOMLIN MILL ROAD, LOT ON LEFT AT BOX # 760

SUBDIVISION _____ BLOCK / SECTION _____ LOT # _____ LOT AREA 2.239 Ac DESIGN FLOW 360 L.T.A.R. 0.30 GPD/FT2

Septic Tank 1000 Gallons: STB 1012 Date 9/29/08

Pump Tank _____ Gallons: P T _____ Date _____

Pump Make _____ Model _____ Serial # _____

Nitrification Field No Fields 1 No Lines 4 Linear Feet 300

Trench Width 36" Max. Trench Bottom Depth 36" Gravel Depth N/A

☑ New System ☐ Repair ☐ Expansion System Type I II (III) IV V VI

System Description: 25% REDUCTION GRAVITY

Repair System Description: 25% REDUCTION, GRAVITY

Maintenance Agreement Required ☐ YES ☑ NO

☑ GRAVITY ☐ PRESSURE

☑ Residence No. Bedrooms 3

☐ Business No. Persons _____

☐ Other No. Employees _____

☐ Slab ☑ Crawl Space


☐ Basement w/plumbing ☐ Basement w/o plumbing

Water Supply: ☐ Private ☐ Public ☑ Community


Comments / Conditions: INSTALL 25% REDUCTION SYSTEM ON CONTOUR AS SHOWN, KEEP SYSTEM MINIMUM 10 FEET FROM PROPERTY LINE.

Comments / Conditions: Red Ly Fell

INITIAL SITE SKETCH

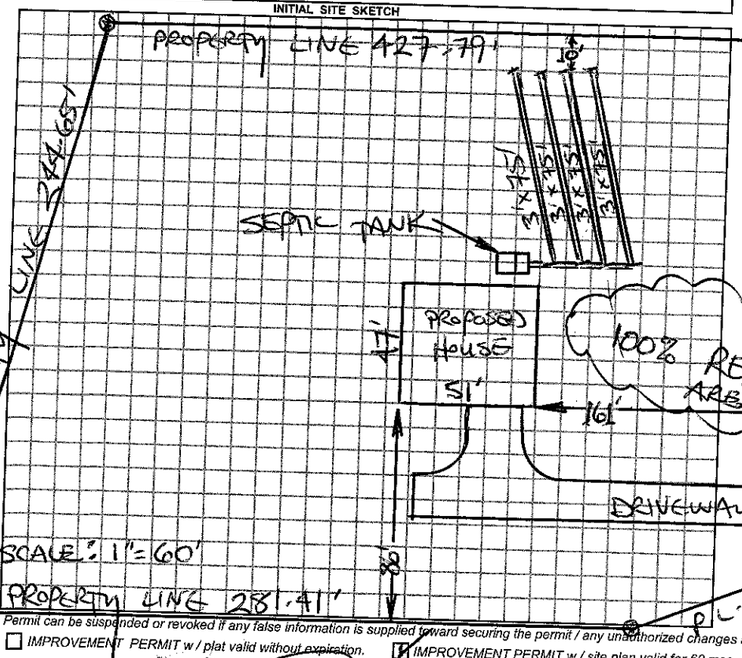

AS BUILT SKETCH

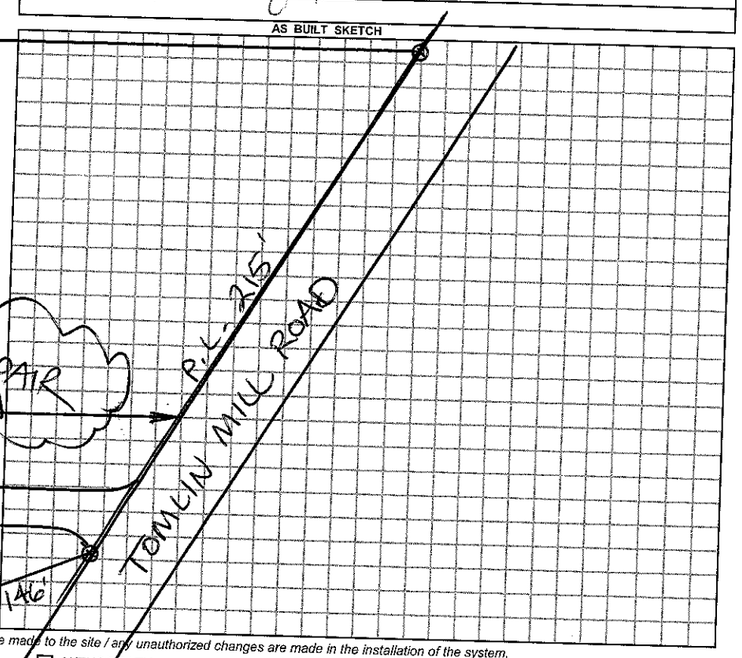

Permit can be suspended or revoked if any false information is supplied toward securing the permit / any unauthorized changes are made to the site / any unauthorized changes are made in the installation of the system.

☐ *IMPROVEMENT PERMIT w / plat valid without expiration.* ☑ *IMPROVEMENT PERMIT w / site plan valid for 60 mos.* ☐ *AUTHORIZATION TO CONSTRUCT valid for period equal to IMPROVEMENT PERMIT-not to exceed 60 mo.*

Owner / Applicant Signature _____ Date 10-17-08

Improvement Permit by: STEVE HEDRICK Date 10-15-08

Authorzation to Construct by: STEVE HEDRICK Date 10-15-08

YOU SHOULD CONTACT A LOCATOR SERVICE PRIOR TO ANY EXCAVATION.

Installed by: Steve Jordan

Operation Permit by: _____ Date: 12 3 -08

Existing System Inspected by: _____ Date: _____

WHITE COPY Environmental Health YELLOW COPY (Final) Owner / Applicant PINK COPY (Initial) Owner / Applicant