IREDELL COUNTY HEALTH DEPARTMENT

STATESVILLE 704-878-5305 MOORESVILLE 704-664-5281

IMPROVEMENT PERMIT / AUTHORIZATION TO CONSTRUCT / OPERATION PERMIT / EXISTING SYSTEM INSPECTION

PERMIT# 095331 PIN# 4759 45 4554 (PT) DATE 4-23-01

OWNER OR CONTRACTOR PHILLIP CHURCH PHONE: Business Home (704) 546-2277

ADDRESS 901 TABOR ROAD, OLIN NC 28660

LOCATION I-77 N, TR TOMLIN MILL RD, TL JOSEY ROAD, TR DRIVEWAY AT BOX #318, BACK OFF ROAD

SUBDIVISION BLOCK / SECTION LOT LOT AREA 2.0 ACRES SITE CLASS PS DESIGN FLOW 360 L.T.A.R. 0.40 GPD/FT²

Septic Tank: 1000 Gallons; STB 1012 Date 9-24-01
Pump Tank: Gallons; PT Date
Pump Make: Model Serial No
Nitrification Field: No Fields 1 Square Feet 900 Linear Feet 300
No Lines FIVE Trench Width 36" Max Trench Bottom Depth 36" Gravel Depth 12"

☑ New System ☐ Repair System Type: I (II) III. IV. V. VI
System Description: CONVENTIONAL GRAVITY
Repair System Description: CONVENTIONAL, pump
Maintenance Agreement Required: ☐ Yes ☑ No


☑ House/Mod. Home No. Bedrooms 3
☐ Mobile Home No. Bathrooms 2
☐ Business No. Employees
☐ Other
☐ Slab ☐ Crawl Space ☐ Basement w/plumbing ☑ Basement wo/plumbing

Water Supply: ☐ Individual ☑ Public ☐ Community

Comments/Conditions: KEEP SYSTEM MINIMUM 15 FEET FROM BASEMENT & BASEMENT CUT (TOP OF EMBANKMENT)

Comments/Conditions: SEPTIC TANK WITH MARKER INSTALLED USING "POLYLOK" FILTER

INITIAL SITE SKETCH

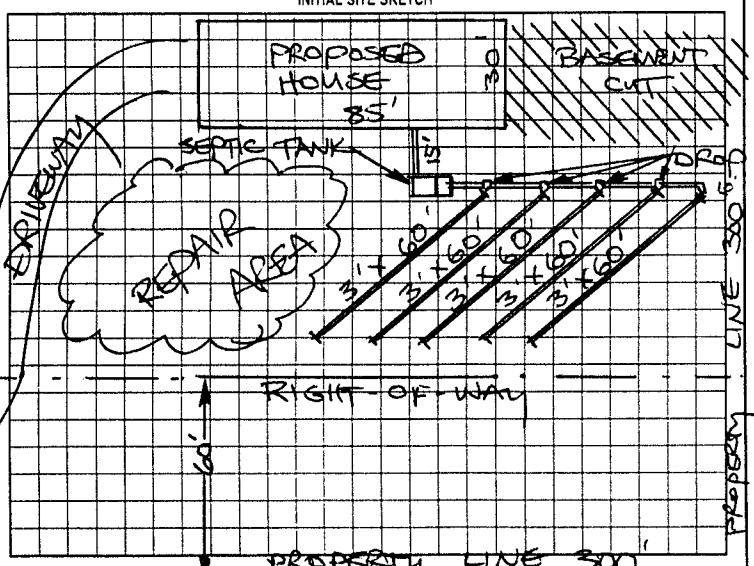

AS BUILT SKETCH

BOXES (4)

SYSTEM INSTALLED ACCORDING TO INITAL SITE SKETCH

Permit can be suspended or revoked if any false information is supplied toward securing the permit/any unauthorized changes are made to the site/any unauthorized changes are made in the installation of the system. Improvement Permit with plat valid without expiration. Improvement Permit with site plan valid for sixty months. Authorization to Construct is valid for a period equal to that of Improvement Permit – not to exceed sixty months.

Signed: Phillip Church date 4-23-01 Installed by: STEVE JORDAN

Improvement Permit by: STEVE HEDRICK date 4-23-01 Operation Permit by: STEVE HEDRICK date 1-30-02

Authorization to Construct by: STEVE HEDRICK date 4-23-01 Existing System Inspection by: date

HEALTH DEPT COPY WHITE OWNER COPY (FINAL) YELLOW OWNER COPY (INITIAL) PINK