# IREDELL COUNTY HEALTH DEPARTMENT

STATESVILLE 704-878-5305 MOORESVILLE 704-664-5281

## IMPROVEMENT PERMIT / AUTHORIZATION TO CONSTRUCT / OPERATION PERMIT / EXISTING SYSTEM INSPECTION

PERMIT# 076993 PIN# 4759 45 4284 (PART) DATE 10-16-98

OWNER OR CONTRACTOR STEVE JORDAN PHONE: Business Home 876-1049

ADDRESS 138 VICTORIA DRIVE, STATESVILLE, NC 28625

LOCATION I-77 N, TR TOMLIN MILL ROAD, TL JOSEY ROAD, TR AT NEW DRIVE R-O-W BEFORE CREEK

SUBDIVISION BLOCK / SECTION LOT LOT AREA 1.778 ACRES SITE CLASS PS DESIGN FLOW 360 L.T.A.R. 0.30 GPD/FT²

Septic Tank: 1000 Gallons; STB 1012 Date 11-7-98
Pump Tank: Gallons; PT Date
Pump Make: Model Serial No.
Nitrification Field: No Fields 1 Square Feet 1200 Linear Feet 400
No Lines FIVE Trench Width 36" Max Trench Bottom Depth 30

[X] New System [ ] Repair System Type: [I] II, III, IV, V, VI
System Description: CONVENTIONAL GRAVITY
Repair System Description: CONV. GRAVITY
Maintenance Agreement Required: [ ] Yes [X] No
Gravel Depth 12" [ ] Slab [ ] Crawl Space [ ] Basement w/plumbing [X] Basement wo/plumbing


[X] House/Mod. Home No. Bedrooms 3
[ ] Mobile Home No. Bathrooms 2
[ ] Business No. Employees
[ ] Other

Water Supply: [X] Individual [ ] Public [ ] Community
WELL


Comments:/Conditions: SCALE: 1" = 60'

Comments:/Conditions:

INITIAL SITE SKETCH

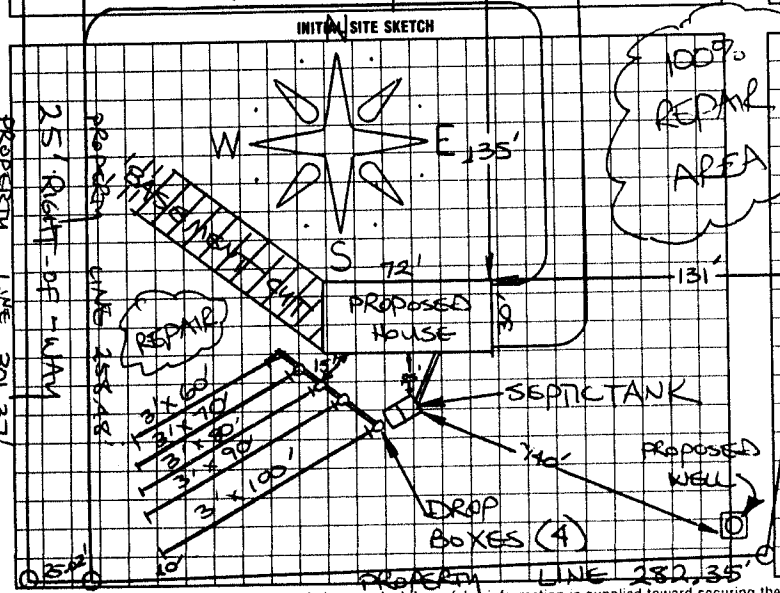


AS BUILT SKETCH

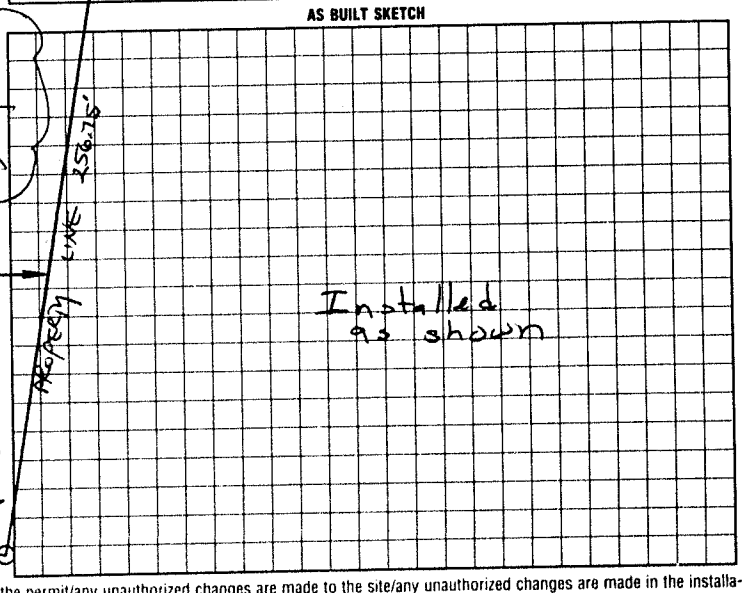


I understand that this permit can be suspended or revoked if any false information is supplied toward securing the permit/any unauthorized changes are made to the site/any unauthorized changes are made in the installation of the system. Improvement Permit with plat valid without expiration. Improvement Permit with site plan valid for sixty months. Authorization to Construct is valid for a period equal to that of Improvement Permit – not to exceed sixty months.

Signed: Steve Jordan date 10-16-98 Installed by: Steve Jordan

Improvement Permit by: STEVE HENDRICK date 10-16-98 Operation Permit by: Mary Cox RS date 4-26-99

Authorization to Construct by: STEVE HENDRICK date 10-16-98 Existing System Inspection by: date

HEALTH DEPT. COPY: WHITE INSPECTION COPY (FINAL): GREEN OWNER COPY (FINAL): YELLOW INSPECTION COPY (INITIAL): PINK OWNER COPY (INITIAL): GOLD