IREDELL COUNTY HEALTH DEPARTMENT

STATESVILLE 704-878-5305 MOORESVILLE 704-664-5281

IMPROVEMENT PERMIT / CERTIFICATE OF COMPLETION / OPERATION PERMIT / EXISTING SYSTEM INSPECTION

PROPERTY DESCRIPTION NO. 23600 DATE 4-29-96 TAX MAP NO. 13H-A-75 Watershed: ☐ Yes ☒ No

OWNER OR CONTRACTOR STEPHEN M. CHURCH PHONE: Business Home 876-1347

ADDRESS 510 FAIRMONT ROAD STATESVILLE, NC 28677

LOCATION I-77N, TR TOMLIM MILL RD, TR FAIRMONT RD, TL EDRA LANE, MH AT END

SUBDIVISION BLOCK / SECTION LOT LOT AREA AMPLE SITE CLASS PS DESIGN FLOW 360 L.T.A.R. 0

Septic Tank: 1000 Gallons; STB Date

Pump Tank: Gallons; PT Date

Pump Make: Model Serial No.

Nitrification Field: No Fields 1 Square Feet 1035 Linear Feet 345

No Lines 3 Trench Width 36" Max Trench Bottom Depth 18-36 Gravel Depth 12"

☐ New System ☐ Repair System Type: I II III IV V VI

System Description: CONVENTIONAL GRAVITY

Repair System Description: CONV. GRAVITY

Maintenance Agreement Required: ☐ Yes ☒ No

☐ Slab ☐ Crawl Space ☐ Basement w/plumbing ☐ Basement wo/plumbing

☐ House/Mod. Home No. Bedrooms 2

☒ Mobile Home No. Bathrooms 2

☐ Business No. Employees

☐ Other


Water Supply: ☐ Individual ☐ Community ☒ Public

Comments:

Comments: ① MH NOT ON SITE AT TIME OF INSPECTION ② KEEP MH MINIMUM 5' FROM SYSTEM ③ NO VEHICULAR TRAFFIC ALLOWED OVER SYSTEM

INITIAL SITE SKETCH

AS BUILT SKETCH

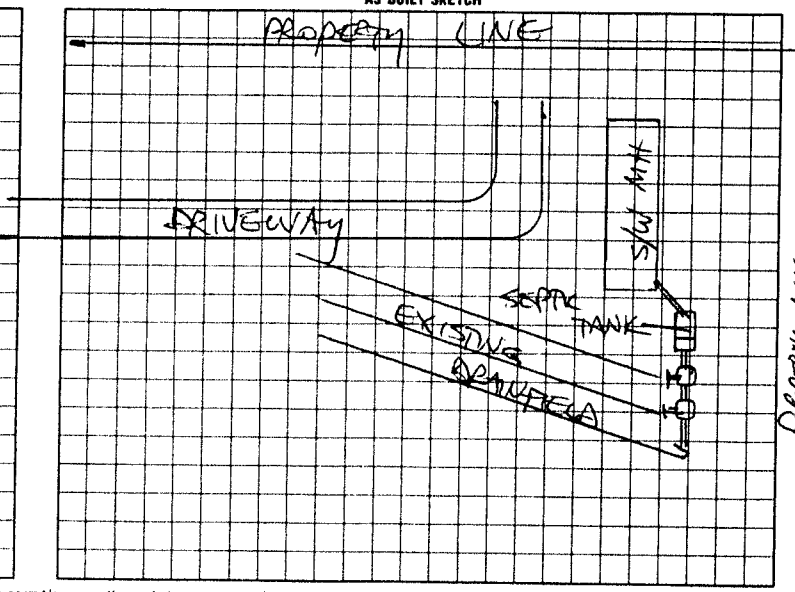

I understand that this permit can be suspended or revoked if any false information is supplied toward securing the permit/any unauthorized changes are made to the site/any unauthorized changes are made in the installation of the system

Signed:

Improvement Permit by: date

Existing System Inspection by: STEVE HEDRICK date 4-29-96

Installed by

Certificate of Completion by date

Operation Permit by date

HEALTH DEPT. COPY: WHITE INSPECTION COPY (FINAL) GREEN OWNER COPY (FINAL) YELLOW INSPECTION COPY (INITIAL) PINK OWNER COPY (INITIAL) GOLD