IREDELL COUNTY HEALTH DEPARTMENT - *ENVIRONMENTAL HEALTH* ☑ STATESVILLE OFFICE 704-878-5305 ☐ MOORESVILLE OFFICE 704-664-5281

IMPROVEMENT PERMIT / AUTHORIZATION TO CONSTRUCT / OPERATION PERMIT / EXISTING SYSTEM INSPECTION

PERMIT # 172510 PIN # 4759510943 DATE 5-18-12

OWNER Stephen & Sara Church APPLICANT: Same PHONE: Home/Cell # 704-252-8234 Business # 704-878-3460

SITE ADDRESS 140 Edra Dr. Statesville NC OWNER / APPLICANT ADDRESS Same

SITE DIRECTIONS I-77 N to Tomlin Mill Exit; Turn Right on Tomlin Mill; R on Fairmount Rd.; (L) on Edra Dr.

SUBDIVISION N/A BLOCK / SECTION N/A LOT # N/A LOT AREA 10.96 acres DESIGN FLOW 360 gpd L.T.A.R. N/A

Septic Tank 1000 Ex Gallons: STB Date
Pump Tank Gallons: P T Date
Pump Make Model Serial #
No. Nitrification Fields: 1 No. Lines 3 Linear Feet 300
Trench Width 36" Max. Trench Bottom Depth 36"

☐ New System ☐ Repair ☐ Expansion System Type I (II) III IV V VI
System Description: Conventional Gravity
Repair System Description: Conventional
Maintenance Agreement Required ☐ YES ☑ NO
Gravel Depth 12" Ex ☑ GRAVITY ☐ PRESSURE

☐ Residence No. Bedrooms 3
☐ Business No. Persons
☐ Other No. Employees
☑ Slab ☐ Crawl Space
☐ Basement w/plumbing ☐ Basement w/o plumbing


Water Supply: ☐ Private ☑ Public ☐ Community

Comments / Conditions

- There is 3' between old SWMH and new house; - Maintain MIN. of 5' between septic system & new house foundation

INITIAL SITE SKETCH

AS BUILT SKETCH

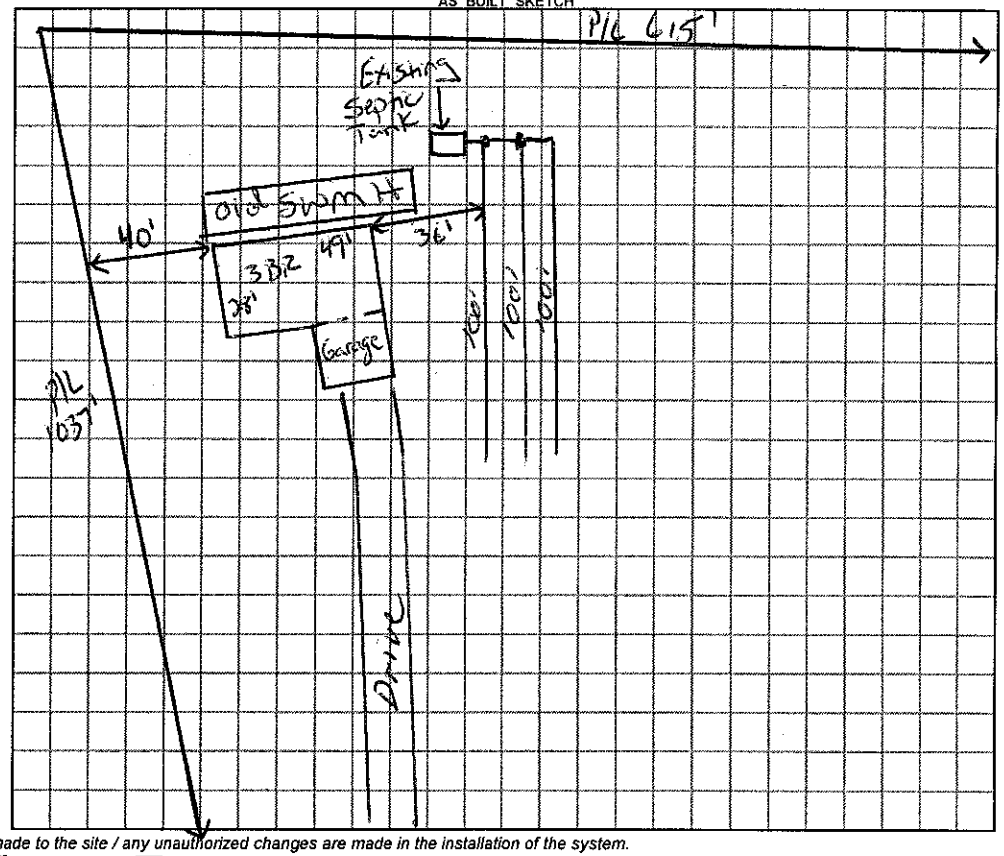

Permit can be suspended or revoked if any false information is supplied toward securing the permit / any unauthorized changes are made to the site / any unauthorized changes are made in the installation of the system.

☐ ***IMPROVEMENT PERMIT*** *with plat valid without expiration.* ☐ ***IMPROVEMENT PERMIT*** *with plat valid without expiration. site plan valid 60 mos* ☐ ***AUTHORIZATION TO CONSTRUCT*** valid for period equal to IMPROVEMENT PERMIT--not to exceed 60 mo.

Owner / Applicant Signature: Date Installed by:

IMPROVEMENT PERMIT by: ***REHS*** Date OPERATION PERMIT by: ***REHS*** Date

AUTHORIZATION TO CONSTRUCT by: ***REHS*** Date Existing System Inspected by: Justin Henderson ***REHS*** Date 5-18-12

YOU SHOULD CONTACT A LOCATOR SERVICE PRIOR TO ANY EXCAVATION

White Copy – Environmental Health YELLOW COPY (Final) Owner / Applicant PINK COPY (Initial) Owner / Applicant