IREDELL COUNTY HEALTH DEPARTMENT

STATESVILLE 704-878-5305 (A) MOORESVILLE 704-664-5281

IMPROVEMENT PERMIT / AUTHORIZATION TO CONSTRUCT / OPERATION PERMIT / EXISTING SYSTEM INSPECTION

PERMIT# 107553 PIN# 4759-62-5779 DATE 7-23-02

OWNER OR CONTRACTOR ANDREW S. KRIDER PHONE: Business Home 704-876-1704

ADDRESS 122 CRITTER LANE, STATESVILLE, NC 28625

LOCATION I-77 N, TR TOWN MILL ROAD, TR CRITTER LANE, 1ST MH ON RIGHT

SUBDIVISION BLOCK / SECTION LOT LOT AREA 4.56 ACRES SITE CLASS 1 PS DESIGN FLOW 600 L.T.A.R. 0.30 GAD/FT2

Septic Tank: 1000 (2ND) Gallons: STB 1072 Date 4-28-02
Pump Tank: Gallons: PT Date
Pump Make: Model Serial No
Nitrification Field: No Fields 1 Square Feet 2000 Linear Feet 366
No Lines THREE Trench Width 36" Max Trench Bottom Depth 36" Gravel Depth 12"

☑ New System ☐ Repair System Type: I (II) III IV V VI
System Description: CONVENTIONAL, GRAVITY
Repair System Description: CONVENTIONAL, PUMP
Maintenance Agreement Required: ☐ Yes ☑ No
☐ Slab ☐ Crawl Space ☐ Basement w/plumbing ☐ Basement wo/plumbing


☐ House/Mod. Home No. Bedrooms 5
☑ Mobile Home No. Bathrooms 2
☐ Business No. Employees
☐ Other

Water Supply: ☐ Individual ☐ Public ☐ Community

Comments/Conditions: REPLACE EXISTING DISTRIBUTION BOX WITH NEW DROP BOX. FEED THREE NEW LINES SERIALLY AS SHOWN.

Comments/Conditions: SEPTIC TANK WITH MARKER INSTALLED USING "TUFFITE" FILTER

INITIAL SITE SKETCH SCALE: 1" = 50'

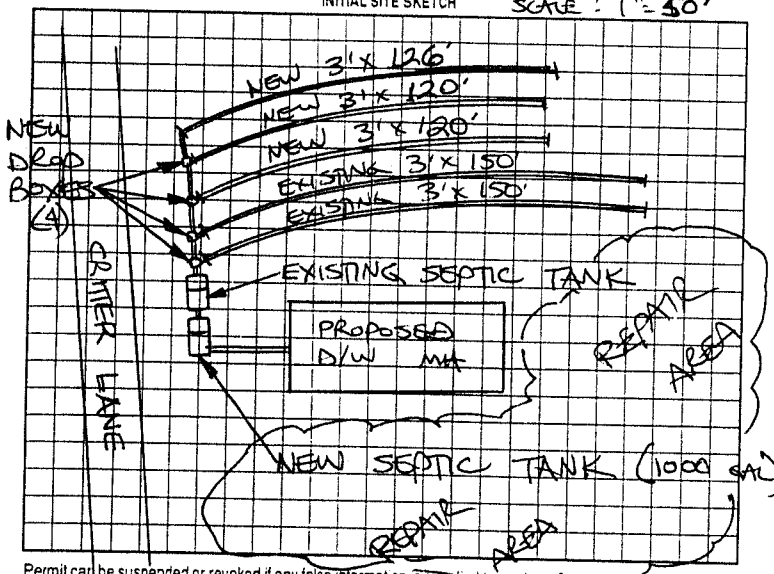

AS BUILT SKETCH

SYSTEM INSTALLED ACCORDING TO INITIAL SITE SKETCH

Permit can be suspended or revoked if any false information is supplied toward securing the permit, any unauthorized changes are made to the site, any unauthorized changes are made in the installation of the system. Improvement Permit with plat valid without expiration. Improvement Permit with site plan valid for sixty months. Authorization to Construct is valid for a period equal to that of Improvement Permit – not to exceed sixty months.

Signed: Jane & Graham date 7/24/02 Installed by A-1 BACKHOE

Improvement Permit by: STEVE HEDRICK, date 7-23-02 Operation Permit by STEVE HEDRICK date 9-6-02

Authorization to Construct by: STEVE HEDRICK date 7-23-02 Existing System Inspection by: date

HEALTH DEPT COPY: WHITE OWNER COPY (FINAL): YELLOW OWNER COPY (INITIAL): PINK