IREDELL COUNTY HEALTH DEPARTMENT

STATESVILLE 704-878-5305 MOORESVILLE 704-664-5281

IMPROVEMENT PERMIT / AUTHORIZATION TO CONSTRUCT / OPERATION PERMIT / EXISTING SYSTEM INSPECTION

PERMIT# 116710 PIN# ~~4759-57-7881.001~~ 4759-63-4625 DATE 11/13/03

OWNER OR CONTRACTOR Michael Shannon Lowman PHONE: Business — Home (704) 400-8298

ADDRESS 680 Tomlin Mill Rd Statesville, N.C. 28625

LOCATION I-77 N. @ 80 on Tomlin Mill Road, ½ mile on Left, past Lowes Distribution Entrance.

SUBDIVISION — BLOCK / SECTION — LOT — LOT AREA 2.05 Acres SITE CLASS. PS DESIGN FLOW 360 L.T.A.R. .30

Septic Tank: 1,000 Gallons; STB 794 Date 1-18-04
Pump Tank: ____ Gallons; PT ____ Date ____
Pump Make: ____ Model ____ Serial No. ____
Nitrification Field: No Fields 1 Square Feet 1200 Linear Feet 400
No Lines 3@133 Trench Width 36" Max Trench Bottom Depth 30" Gravel Depth 12"

☒ New System ☐ Repair System Type: I, II, III, IV, V, VI
System Description: Gravity, Conventional
Repair System Description: Gravity, 25% Reduction
Maintenance Agreement Required: ☐ Yes ☒ No

☒ House/Mod. Home No. Bedrooms 3
☐ Mobile Home No. Bathrooms 2
☐ Business No. Employees ____
☐ Other ____


☐ Slab ☒ Crawl Space ☐ Basement w/plumbing ☐ Basement wo/plumbing

Water Supply: ☐ Individual ☒ Public ☐ Community

Comments/Conditions: ① Install lines on contour ② Do not install when wet

Comments/Conditions: - poly lok filter + ST Marker Installed

INITIAL SITE SKETCH Scale 1" = 1'

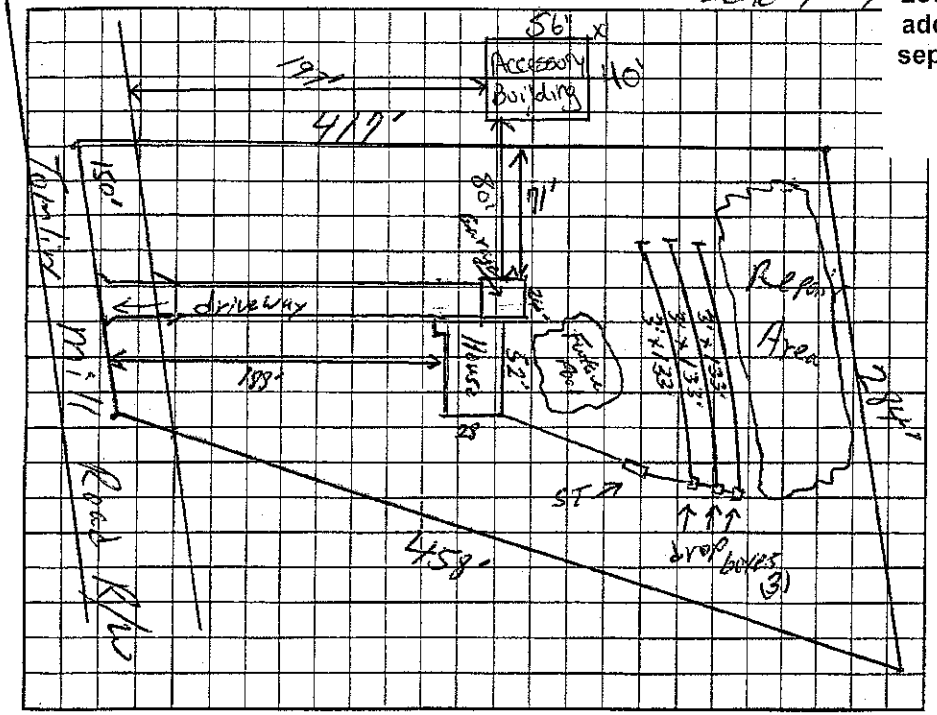

Location of the proposed 40'X56' Accessory Building addition does not appear to impact the existing on-site septic system.NOTE:** Justin Henderson REHS
Date: 1-11-13
ICHD-Environmental Health Division

As-Installed As Shown Per Initial Site Sketch

Permit can be suspended or revoked if any false information is supplied toward securing the permit/any unauthorized changes are made to the site/any unauthorized changes are made in the installation of the system. Improvement Permit with plat valid without expiration. Improvement Permit with site plan valid for sixty months. Authorization to Construct is valid for a period equal to that of Improvement Permit – not to exceed sixty months.

Signed: [signature] date 11-17-03 Installed by: Shannon Lowman

Improvement Permit by: William O. Johnson date 11/13/03 Operation Permit by: William O. Johnson date 02/23/04

Authorization to Construct by: William O. Johnson date 11/13/03 Existing System Inspection by: ____ date ____

HEALTH DEPT. COPY: WHITE OWNER COPY (FINAL): YELLOW OWNER COPY (INITIAL): PINK