IREDELL COUNTY HEALTH DEPARTMENT

STATESVILLE 704-878-5305 MOORESVILLE 704-664-5281

IMPROVEMENT PERMIT / AUTHORIZATION TO CONSTRUCT / OPERATION PERMIT / EXISTING SYSTEM INSPECTION

PERMIT# Repair PIN# 4759 63 4252 DATE 4-23-07

OWNER OR APPLICANT William S. Krider PHONE: Business Home 704 876 2505

ADDRESS 683 Tomlin Mill Rd

LOCATION I-77 N to (R) on Tomlin Mill Rd. Lot on (R) immediately adjacent to Critter Lane

SUBDIVISION n/a BLOCK / SECTION LOT n/a LOT AREA SITE CLASS. PS DESIGN FLOW 360 L.T.A.R. .3

Septic Tank: 1000 (Exist) Gallons: STB Date

Pump Tank: Gallons: PT Date

Pump Make: Model Serial No.

Nitrification Field: No Fields 1 Square Feet 1200 Linear Feet 300

No Lines 4 Trench Width 36" Max Trench Bottom Depth 36" Gravel Depth

☐ New System ☒ Repair ☐ Expansion System Type: (II) III IV V VI

System Description:

Repair System Description: 25% Reduction

Maintenance Agreement Required: ☐ Yes ☐ No

☒ House/Mod. Home ☐ Mobile Home ☐ Business ☐ Other

No. Bedrooms 3 No. Persons No. Employees

Water Supply: ☐ Individual ☒ Public ☐ Community


☒ Gravity ☐ Pressure ☐ Slab ☒ Crawl Space ☐ Basement w/plumbing ☐ Basement wo/plumbing

Comments:/Conditions:

* need easement to cross line from * 4759 63 4252 to 4759 63 5002

Comments:/Conditions:

INITIAL SITE SKETCH

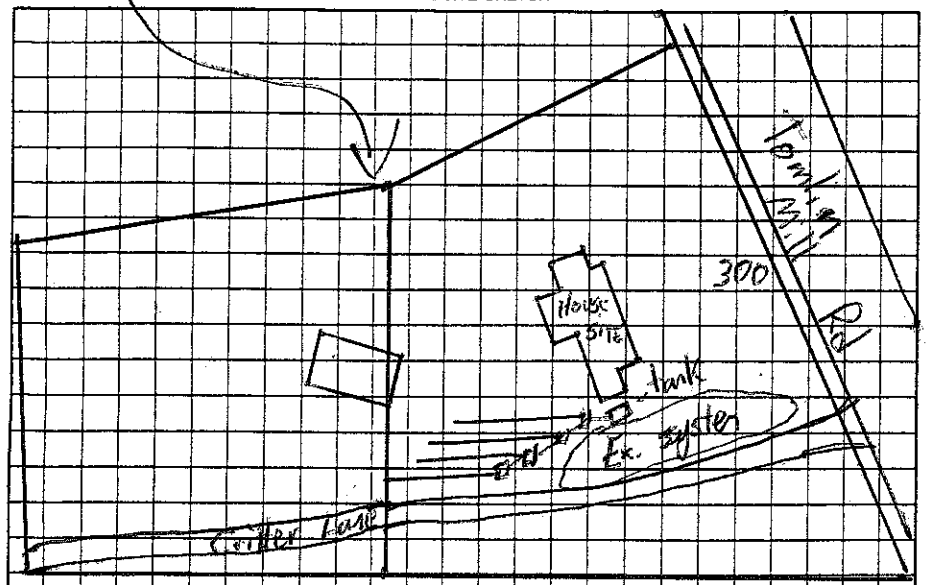

(4) 3' x 75' lines
4 drop boxes

new tank may be installed if necessary

AS BUILT SKETCH

Permit can be suspended or revoked if any false information is supplied toward securing the permit/any unauthorized changes are made to the site/any unauthorized changes are made in the installation of the system. Improvement Permit with plat valid without expiration ☐ Improvement Permit with site plan valid for sixty months ☐ Authorization to Construct is valid for a period equal to that of Improvement Permit – not to exceed sixty months.

Signed: Peggy Krider date 5/5/07 Installed by: Steve Jordan

Improvement Permit by: date 4-24-07 Operation Permit by: date 5-23-07

Authorization to Construct by: date 5-14-07 Existing System Inspection by: date

HEALTH DEPT. COPY: WHITE OWNER COPY (FINAL): YELLOW OWNER COPY (INITIAL): PINK