IREDELL COUNTY HEALTH DEPARTMENT

STATESVILLE 704-878-5305 MOORESVILLE 704-664-5281

IMPROVEMENT PERMIT / CERTIFICATE OF COMPLETION / OPERATION PERMIT / EXISTING SYSTEM INSPECTION

PROPERTY DESCRIPTION NO. 17002 DATE 9/15/93 TAX MAP NO. Pt of 13L-A-49

OWNER OR CONTRACTOR WARREN R. HILKERT PHONE: Business 873-9516 Home

ADDRESS 413 TONIA DR, STATESVILLE, NC 28677

LOCATION I-77N, TR TOMLIN MILL RD, TL RASH RD, ~1 MILE ON (L) BACK OFF ROAD

SUBDIVISION BLOCK / SECTION LOT LOT AREA 15.136 SITE CLASS. PS L.T.A.R. 0.35 GPD/FT²

Water Supply: ☑ Individual ☐ Community ☐ Public

Septic Tank: 1000 Gallons; STB 1012 Date 8/20/93

Pump Tank: Gallons; PT Date

Nitrification Field: No Fields 1 Square Feet 1035 Linear Feet 345

No Lines 3 Trench Width 36" Trench Depth 18-36" Gravel Depth 12"

☑ New System ☐ Repair System Type: (I) II. IV. V. VI

System Description: CONV. GRAVITY

Repair System Description: CONV. GRAVITY

Maintenance Agreement Required: ☐ Yes ☑ No

☑ House/Mod. Home No. Bedrooms 3

☐ Mobile Home No. Bathrooms 2.5

☐ Business No. Employees

☐ Other TEMPORARY MH SITE

Garbage Disposal: ☐ Yes ☑ No

Auto. Dishwasher: ☑ Yes ☐ No


Auto. Washing Machine: ☑ Yes ☐ No

Other 55 GAL SPA

☐ Slab ☑ Crawl Space ☐ Basement w/plumbing ☐ Basement wo/plumbing

Comments (1) KEEP SYSTEM MINIMUM 5' FROM HOUSE, 10' FROM PROPERTY LINE, 100' FROM WELL (2) INSTALL LINES ON CONTOUR, NO DEEPER THAN 36", 9' APART ON CENTER. (3) MH TO BE REMOVED UPON OCCUPANCY OF HOUSE

INITIAL SITE SKETCH

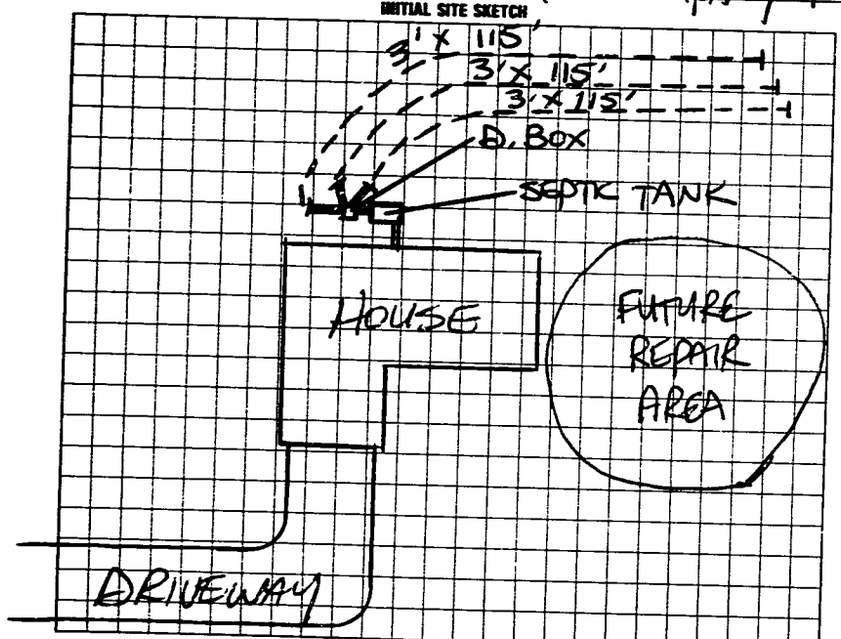

AS BUILT SKETCH

SYSTEM INSTALLED ACCORDING TO INITIAL SITE SKETCH.

I understand that this permit can be suspended or revoked if any false information is supplied toward securing the permit/any unauthorized changes are made to the site/any unauthorized changes are made in the installation of the system. Improvement Permit is valid for 60 months from date of issuance.

Signed: Warren R. Hilkert

Improvement Permit by: STEVE HEDRICK date 9/15/93

Existing System Inspection by: date

Installed by: TOMMY FRYE

Certificate of Completion by: STEVE HEDRICK date 11/23/93

Operation Permit by: date

HEALTH DEPT. COPY: WHITE INSPECTION COPY (FINAL): GREEN OWNER COPY (FINAL): YELLOW INSPECTION COPY (INITIAL): PINK OWNER COPY (INITIAL): GOLD