IREDELL COUNTY HEALTH DEPARTMENT

Statesville Phone TR 3-7271 Mooresville Phone NO 3-1271

PERMIT TO INSTALL SEPTIC TANK

Permit No. 171 Permit Date March 8 1971

Owner L. R. Findley Address Olin Rt #1

Installed By Roy Lentz Address Rt 5 - Statesville


Location of Property First Rd. Right Past Tomlin Bro. on Jennings Rd. Cross creek first Rd. Left, first House on Right

Tank		Capacity		Length of Lines		Fixtures	
Block	( )	1000	(✓)	225'	(✓)	No. of Baths	( )
Precast	(✓)	1250	( )	250'	( )	Dishwasher	( )
		1500	( )	Other		Garbage Grdr.	( )
		Other				Other	

NOTIFY HEALTH DEPARTMENT AT LEAST EIGHT HOURS BEFORE TANK IS TO BE INSPECTED.

Final Inspection 19 Approved ( ) Disapproved ( )

Remarks

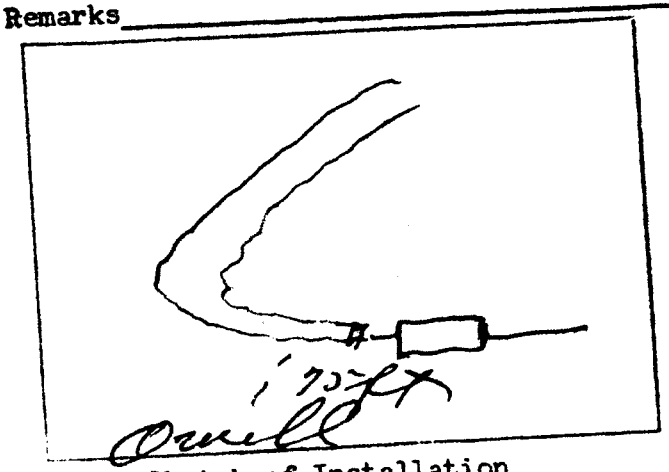

Sketch of Installation

Not Checked by Sanitarian

Sanitarian