IREDELL COUNTY HEALTH DEPARTMENT

Statesville Phone TR 3-7271 Mooresville Phone NO 3-1271

PERMIT TO INSTALL SEPTIC TANK

Permit No. 171 Permit Date March 8 1971

Owner L. R. Pendley Address Olin Rt #1

Installed By Roy Funk Address Rt 5 - Statesville


Location of Property First Rd. Right Past Tomlin Bro. on Jennings Rd Cross creek first Rd. Left first House on Right

Tank		Capacity		Length of Lines		Fixtures	
Block	( )	1000	(✓)	225'	(✓)	No. of Baths	( )
Precast	(✓)	1250	( )	250'	( )	Dishwasher	( )
		1500	( )	Other_____		Garbage Grdr.	( )
		Other_____				Other_____	

NOTIFY HEALTH DEPARTMENT AT LEAST EIGHT HOURS BEFORE TANK IS TO BE INSPECTED.

Final Inspection_____19___ Approved ( ) Disapproved ( )

Remarks_____

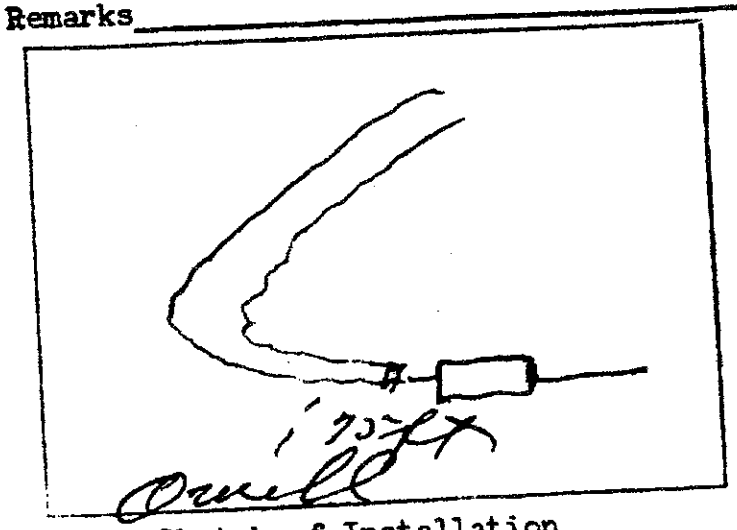

Sketch of Installation

Not Checked by Sanitarian

Location of the proposed detached garage addition does not appear to impact the existing on-site septic system.**NOTE:

REHS

Date: 12-22-11

ICHD-Environmental Health Division

Sanitarian

IREDELL COUNTY HEALTH DEPARTMENT
ENVIRONMENTAL DIVISION
318 TURNERSBURG HIGHWAY
STATESVILLE, NC 28625
COURIER 09-36-07