(230) FORM

IREDELL COUNTY HEALTH DEPARTMENT

STATESVILLE 704-878-5305 MOORESVILLE 704-664-5281

IMPROVEMENT PERMIT / AUTHORIZATION TO CONSTRUCT / OPERATION PERMIT / EXISTING SYSTEM INSPECTION

DATE 6/5/00

PERMIT# REPAIR PIN# REPAIR 4760003994 PHONE: Business 872-5321 Home

OWNER OR CONTRACTOR DERRECK GILLEY

ADDRESS 810 HOUSTON RD - TROUTMAN

LOCATION 21/115 N - TR HOUSTON RD - LAST HOUSE ON RT - # 810

SUBDIVISION — BLOCK / SECTION — LOT — LOT AREA ~4AC SITE CLASS. 15 DESIGN FLOW 360 L.T.A.R. —

Septic Tank: 1000 Gallons; STB 312 Date 10/22/00

Pump Tank: Gallons; PT Date

Pump Make: Model Serial No.

Nitrification Field: No Fields 1 Square Feet 900 Linear Feet 300

No Lines 3@100' Trench Width 36" Max Trench Bottom Depth 36" Gravel Depth 12"

☐ New System ☑ Repair System Type: I, II, III, IV, V, VI

System Description: GRAVITY CONVENTIONAL

Repair System Description: GRAVITY CONVENTIONAL

Maintenance Agreement Required: ☐ Yes ☑ No

☑ House/Mod. Home ☐ Mobile Home ☑ Business ☐ Other

No. Bedrooms 3 No. Bathrooms 3 No. Employees


Water Supply: ☑ Individual ☐ Public ☐ Community

☐ Slab ☑ Crawl Space ☐ Basement w/plumbing ☐ Basement wo/plumbing


Comments:/Conditions: 1) CUT OFF OLD SYSTEM 2) SET NEW TANK AND ADD 3@100' NEW CONVENTIONAL LINES

Comments:/Conditions:

INITIAL SITE SKETCH

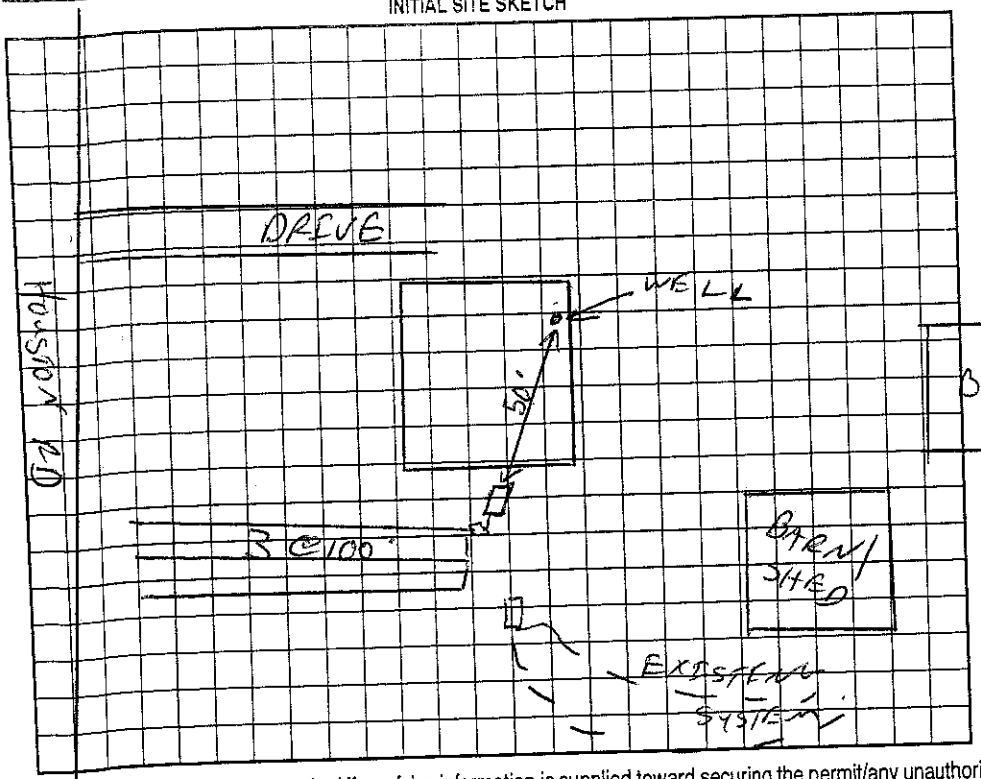

AS BUILT SKETCH

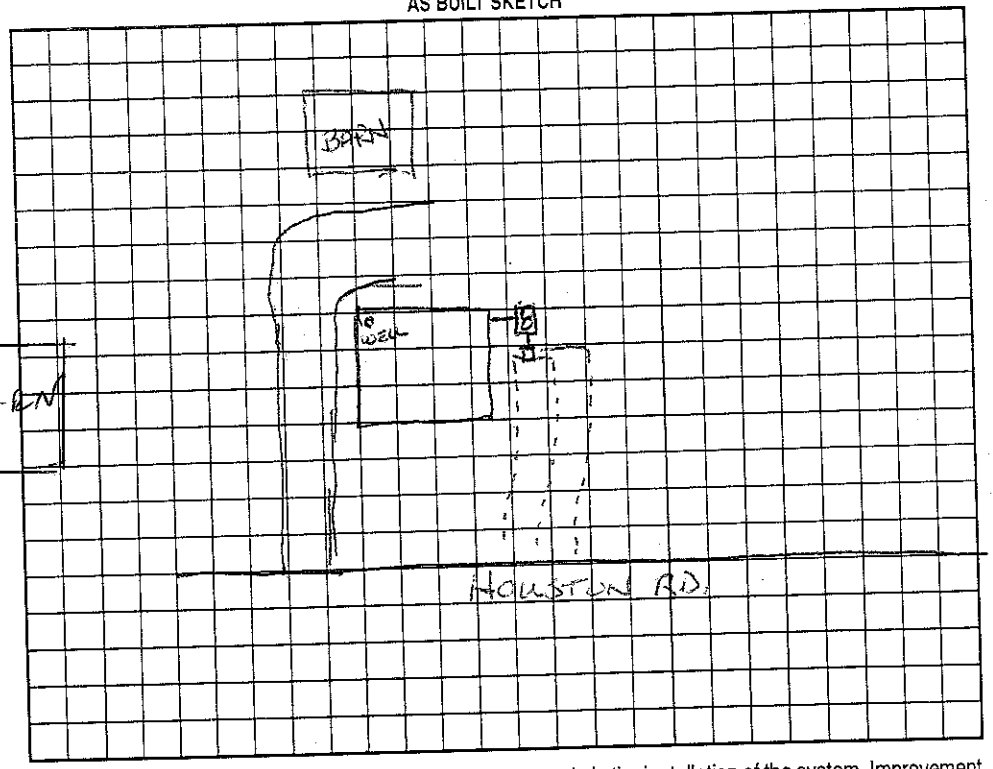

Permit can be suspended or revoked if any false information is supplied toward securing the permit/any unauthorized changes are made to the site/any unauthorized changes are made in the installation of the system. Improvement Permit with plat valid without expiration. Improvement Permit with site plan valid for sixty months. Authorization to Construct is valid for a period equal to that of Improvement Permit – not to exceed sixty months.

Signed: date 6-7-00

Improvement Permit by: date 6/5/00

Authorization to Construct by: date 6/5/00

Installed by: F.J. Erwin

Operation Permit by: Wesley Sparks RS date 12/20/00

Existing System Inspection by: date

HEALTH DEPT. COPY: WHITE OWNER COPY (FINAL): YELLOW OWNER COPY (INITIAL): PINK