4760 066552

# IREDELL COUNTY HEALTH DEPARTMENT

STATESVILLE 704-878-5305 MOORESVILLE 704-664-5281

## IMPROVEMENT PERMIT / CERTIFICATE OF COMPLETION / OPERATION PERMIT / EXISTING SYSTEM INSPECTION

PROPERTY DESCRIPTION NO. 21876 DATE 9/6/95 TAX MAP NO. 4660 B 41 Watershed: ☐ Yes ☒ No

OWNER OR CONTRACTOR Jordan Phifer PHONE: Business _____ Home 664-2595

ADDRESS Heck Ln. Troutman, NC 28166

LOCATION Brevard Country TR Overcash TR Weathers Creek TR Heck Ln., 1st trailer on (R)

SUBDIVISION _____ BLOCK / SECTION _____ LOT _____ LOT AREA _____ SITE CLASS P5 DESIGN FLOW 240 L.T.A.R. .35

Septic Tank: 1000 Gallons; STB 620 Date 9/20/95

Pump Tank: _____ Gallons; PT _____ Date _____

Pump Make: _____ Model 800 Serial No. _____

Nitrification Field: No Fields 1 Square Feet ~~450~~ Linear Feet ~~450~~ 266

No Lines ~~3~~ 4 Trench Width 36" Max Trench Bottom Depth 36" Gravel Depth N/A

☒ New System ☐ Repair System Type: I (II) III IV, V, VI

System Description: ~~STRETCHER~~ OR CONV.

Repair System Description: SAME

Maintenance Agreement Required: ☐ Yes ☒ No

☐ House/Mod. Home No. Bedrooms 3

☒ Mobile Home No. Bathrooms 1

☐ Business No. Employees ____


☐ Other _____

☐ Slab ☐ Crawl Space ☐ Basement w/plumbing ☐ Basement wo/plumbing

Water Supply: ☒ Individual ☐ Community ☐ Public

Comments:

INITIAL SITE SKETCH

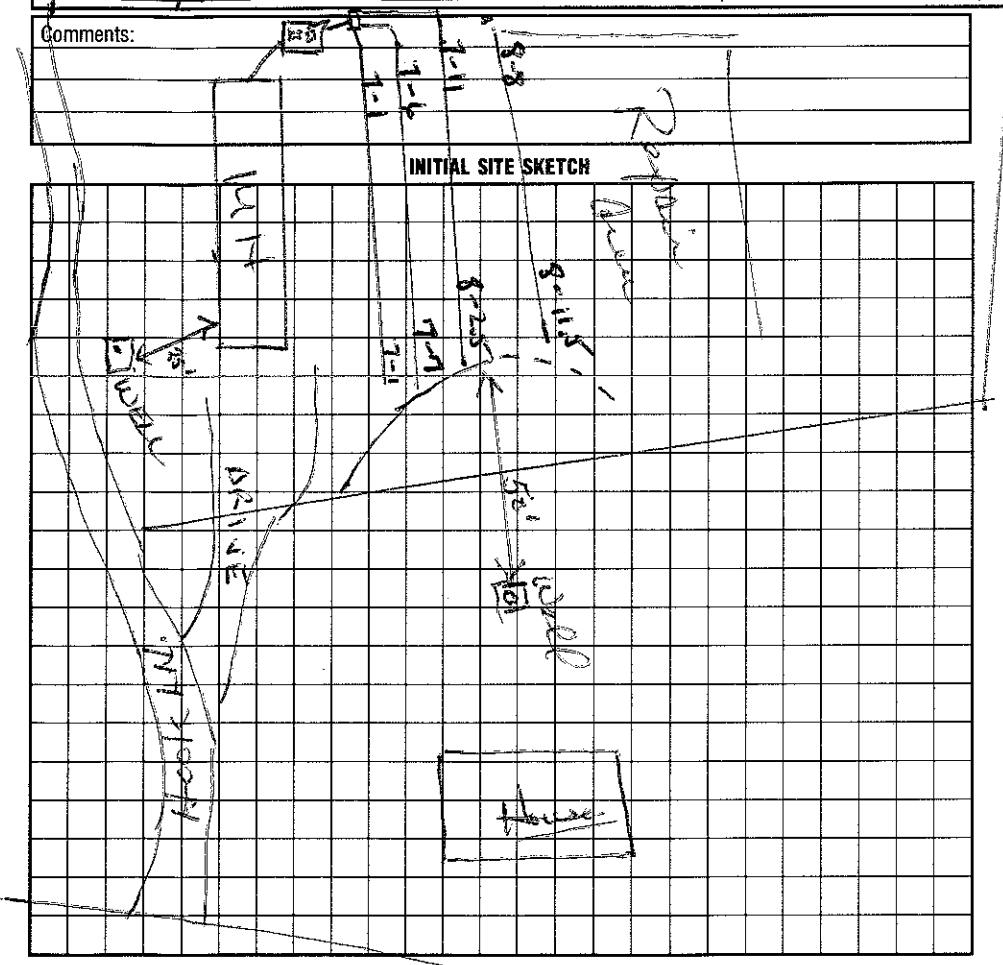


Comments:

10/16/95 changed to conventional

installed as shown on disp. Permit

AS BUILT SKETCH

I understand that this permit can be suspended or revoked if any false information is supplied toward securing the permit/any unauthorized changes are made to the site/any unauthorized changes are made in the installation of the system.

Signed: Jordan Phifer Weathers Creek

Improvement Permit by: Wesley Sparks RS. date 9/6/95

Existing System Inspection by: _____ date _____

Installed by: Sam Revis

Certificate of Completion by: Wesley Sparks RS. date 11/27/95

Operation Permit by: Wesley Sparks RS. date 11/27/95

HEALTH DEPT. COPY: WHITE INSPECTION COPY (FINAL): GREEN OWNER COPY (FINAL): YELLOW INSPECTION COPY (INITIAL): PINK OWNER COPY (INITIAL): GOLD