IREDELL COUNTY HEALTH DEPARTMENT

STATESVILLE 704-878-5305 MOORESVILLE 704-664-5281

IMPROVEMENT PERMIT / CERTIFICATE OF COMPLETION / OPERATION PERMIT / EXISTING SYSTEM INSPECTION

Watershed: ☐ Yes ☒ No

PROPERTY DESCRIPTION NO. 21876 DATE 9/6/95 TAX MAP NO. 46B41

OWNER OR CONTRACTOR Jordan Phifer PHONE: Business ______ Home 664-2575

ADDRESS Hook Ln. Troutman, NC 28166

LOCATION Bluefield Quarry TR Overcash TR Weathers Creek TR Hook Ln., 1st trailer on R.

SUBDIVISION ______ BLOCK / SECTION ______ LOT ______ LOT AREA ______ SITE CLASS. PS DESIGN FLOW 240 L.T.A.R. .35

Septic Tank: 1000 Gallons; STB 620 Date 9/20/95

Pump Tank: ______ Gallons; PT ______ Date ______

Pump Make: ______ Model 300 Serial No. ______

Nitrification Field: No Fields 1 Square Feet ~~[illegible]~~ Linear Feet ~~[illegible]~~ 266

No Lines X4 Trench Width 36" Max Trench Bottom Depth 36" Gravel Depth N/A

☒ New System ☐ Repair System Type: I (II) (III) IV, V, VI

System Description: ~~[illegible]~~ CONV.

Repair System Description: SAME

Maintenance Agreement Required: ☐ Yes ☒ No

☐ House/Mod. Home ☒ Mobile Home ☐ Business ☐ Other ______

No. Bedrooms 2 No. Bathrooms 1 No. Employees ______

Water Supply: ☒ Individual ☐ Community ☐ Public


☐ Slab ☐ Crawl Space ☐ Basement w/plumbing ☐ Basement wo/plumbing

Comments:

Comments: 10/16/95 changed to conventional

Installed as drawn on Imp. Permit

INITIAL SITE SKETCH

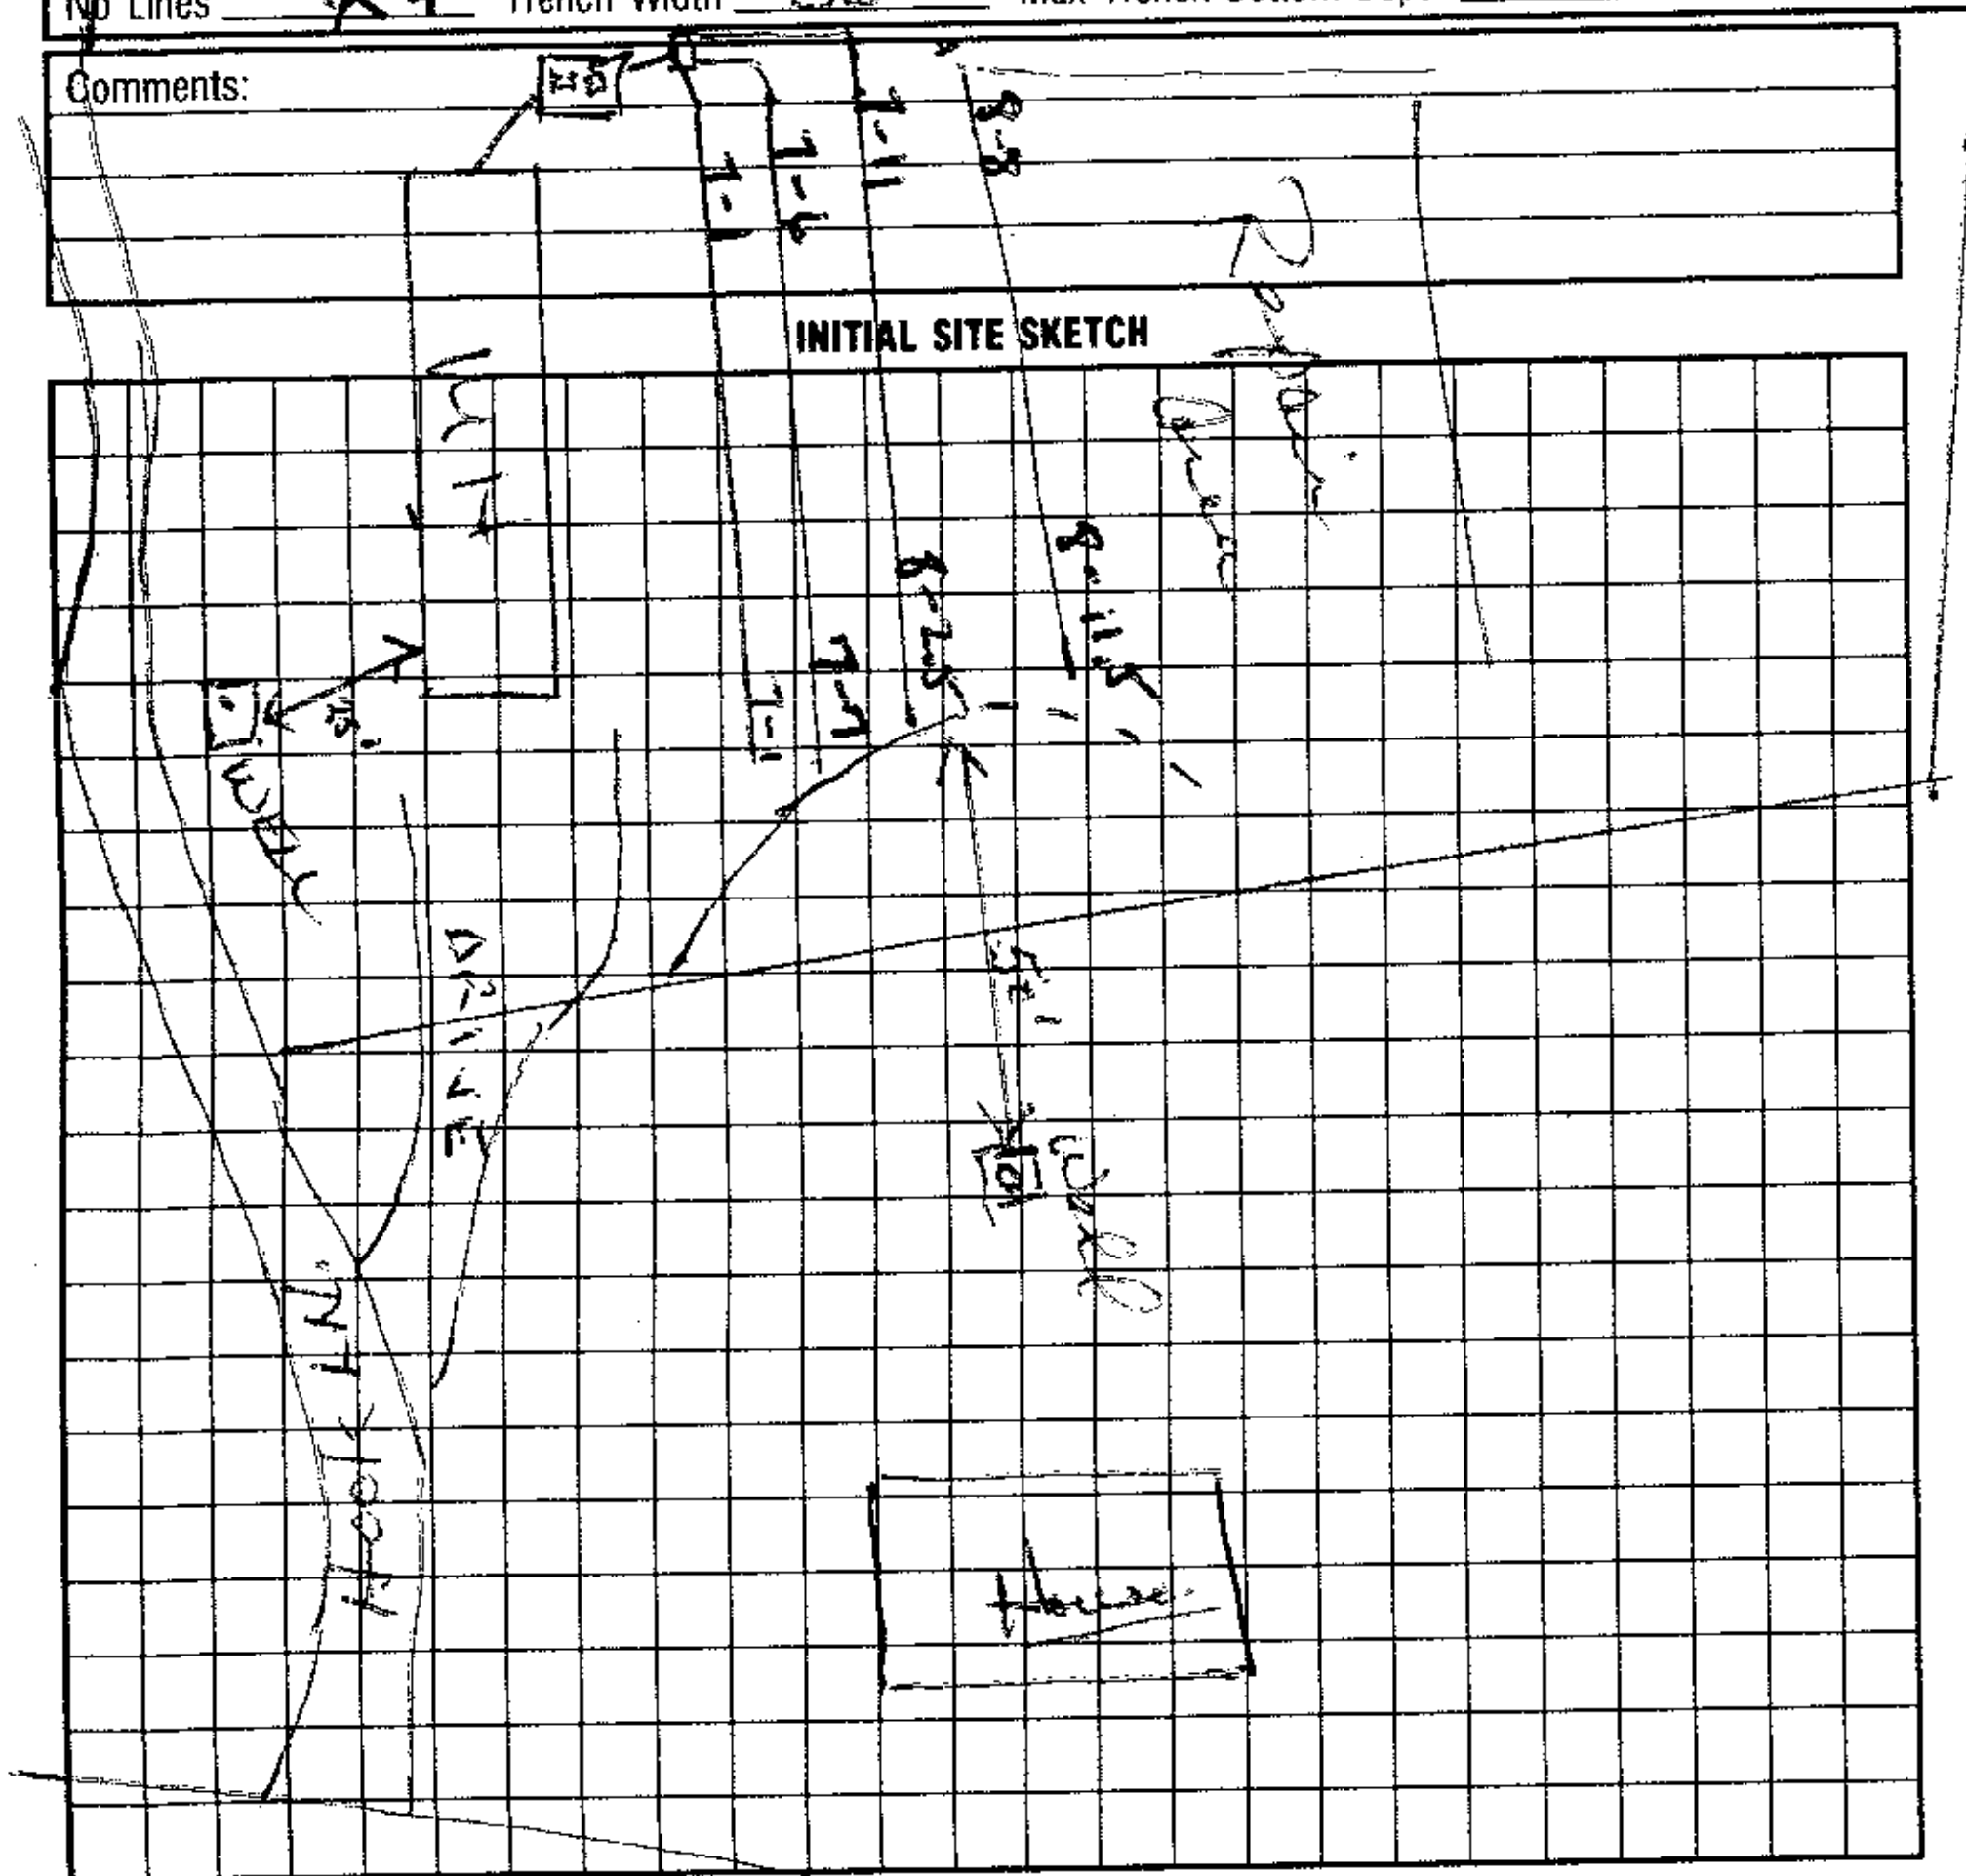

AS BUILT SKETCH

I understand that this permit can be suspended or revoked if any false information is supplied toward securing the permit/any unauthorized changes are made to the site/any unauthorized changes are made in the installation of the system.

Signed: Jordan Phifer

Improvement Permit by: Wesley Sparks RS. date 9/6/95

Existing System Inspection by: ______ date ______

Installed by: Sany Revis

Certificate of Completion by: Wesley Sparks RS. date 11/27/95

Operation Permit by: Wesley Sparks RS. date 11/27/95

HEALTH DEPT. COPY: WHITE INSPECTION COPY (FINAL): GREEN OWNER COPY (FINAL): YELLOW INSPECTION COPY (INITIAL): PINK OWNER COPY (INITIAL): GOLD