IREDELL COUNTY HEALTH DEPARTMENT

STATESVILLE 704-878-5305 MOORESVILLE 704-664-5281

IMPROVEMENT PERMIT / AUTHORIZATION TO CONSTRUCT / OPERATION PERMIT / EXISTING SYSTEM INSPECTION

PERMIT# 076449 PIN# 4760 07 2365 4760 72 4401 4760 07 1521 DATE Sept. 9, '98

OWNER OR CONTRACTOR Cozette Ramsey PHONE: Business Home 528-6066

ADDRESS 415 Weathers Creek Rd.

LOCATION from Shiloh Valley Rd - Weathers Creek Rd. 2nd M.H. on Right past Winford Rd.

SUBDIVISION BLOCK / SECTION LOT LOT AREA ~1½ Ac SITE CLASS. PS DESIGN FLOW 480 gpd L.T.A.R. .3

Septic Tank: 1000 Gallons; STB 1012 Date 7/11/98

Pump Tank: Gallons; PT Date

Pump Make: Model Serial No.

Nitrification Field: No Fields 1 Square Feet 1200 Linear Feet 400

No Lines 5 @ 80' Trench Width 36" Max Trench Bottom Depth 36" Gravel Depth NA

☑ New System ☐ Repair System Type: I, II, III, IV, V, VI

System Description: GRAVITY 25% Reduction

Repair System Description: Same

Maintenance Agreement Required: ☐ Yes ☑ No

☐ House/Mod. Home No. Bedrooms 4

☑ Mobile Home D.W. No. Bathrooms 2-3

☐ Business No. Employees

☐ Other


☐ Slab ☑ Crawl Space ☐ Basement w/plumbing ☐ Basement wo/plumbing

Water Supply: ☑ Individual ☐ Public ☐ Community

Comments:/Conditions:

GT Well

Not to Scale **INITIAL SITE SKETCH**

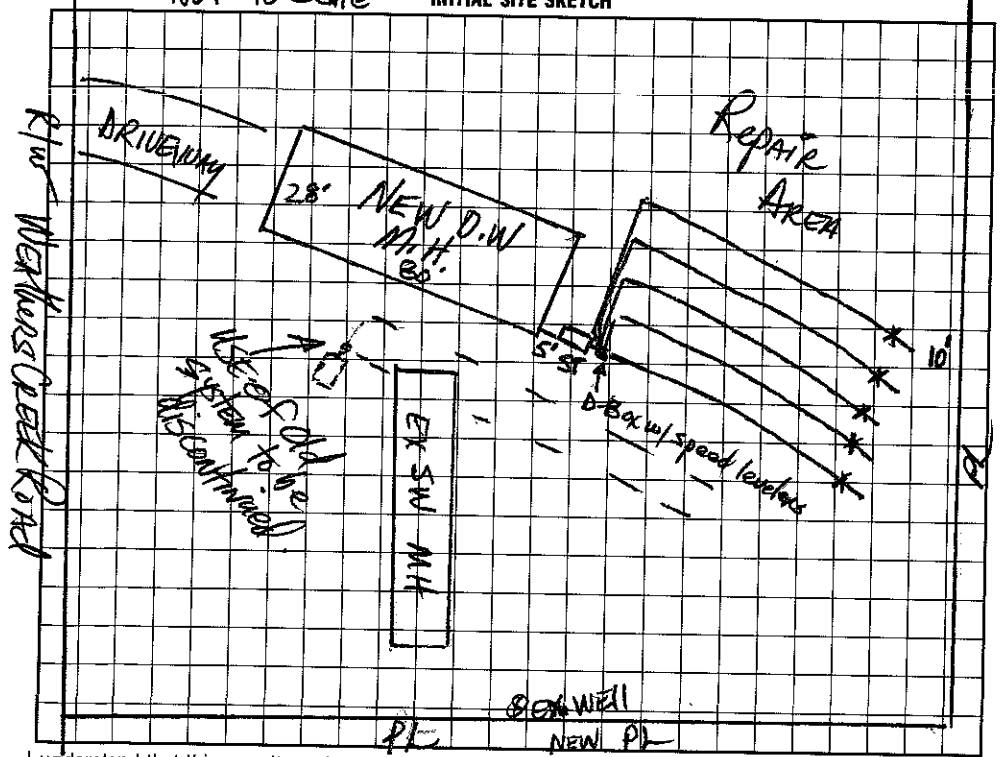

Comments:/Conditions:

* ONE INSPECTION PORT PER LATERAL

According to owner, EX SW Mobile Home to have Bathrooms Removed and to be converted to storage. This must meet Zoning & Bld Insp. Requirements

AS BUILT SKETCH

I understand that this permit can be suspended or revoked if any false information is supplied toward securing the permit/any unauthorized changes are made to the site/any unauthorized changes are made in the installation of the system. Improvement Permit with plat valid without expiration. Improvement Permit with site plan valid for sixty months. Authorization to Construct is valid for a period equal to that of Improvement Permit – not to exceed sixty months.

Signed: date 9-10-98

Improvement Permit by: date 9-9-98

Authorization to Construct by: date 9-9-98

Installed by: A1 BACKHOE

Operation Permit by: date 9/17/98

Existing System Inspection by: date

HEALTH DEPT. COPY: WHITE INSPECTION COPY (FINAL): GREEN OWNER COPY (FINAL): YELLOW INSPECTION COPY (INITIAL): PINK OWNER COPY (INITIAL): GOLD