IREDELL COUNTY HEALTH DEPARTMENT

STATESVILLE 704-878-5305 MOORESVILLE 704-664-5281

IMPROVEMENT PERMIT / AUTHORIZATION TO CONSTRUCT / OPERATION PERMIT / EXISTING SYSTEM INSPECTION

PERMIT# 073845 PIN# 4760 086188 DATE 7/2/98

OWNER OR CONTRACTOR FRED WRIGHT PHONE: Business Home

ADDRESS 120 WEIGAIS VIEW LN MOORESVILLE NC 28115

LOCATION 21N - TR - SAINVILLE - TL WEATHERS - TR RED CLAY DR - ON LT

SUBDIVISION — BLOCK / SECTION — LOT — LOT AREA 22.47AC SITE CLASS. RS DESIGN FLOW 360 L.T.A.R. .3

Septic Tank: 1000 Gallons; STB 794 Date 5/27/98
Pump Tank: Gallons; PT Date
Pump Make: Model Serial No.
Nitrification Field: No Fields 1 Square Feet 1200 Linear Feet 400
No Lines 4@100' Trench Width 36" Max Trench Bottom Depth 36" Gravel Depth 12"

☑ New System ☐ Repair System Type: I, II, III, IV, V, VI
System Description: GRAVITY CONVENTIONAL
Repair System Description: PUMP CHAMBERS OR HDS
Maintenance Agreement Required: ☐ Yes ☑ No

☐ House/Mod. Home No. Bedrooms 3
☑ Mobile Home No. Bathrooms 2
☐ Business No. Employees
☐ Other
☐ Slab ☑ Crawl Space ☐ Basement w/plumbing ☐ Basement wo/plumbing


Water Supply: ☑ Individual ☐ Public ☐ Community

Comments:/Conditions:

(22.47AC)

Comments:/Conditions:

INITIAL SITE SKETCH NOT TO SCALE

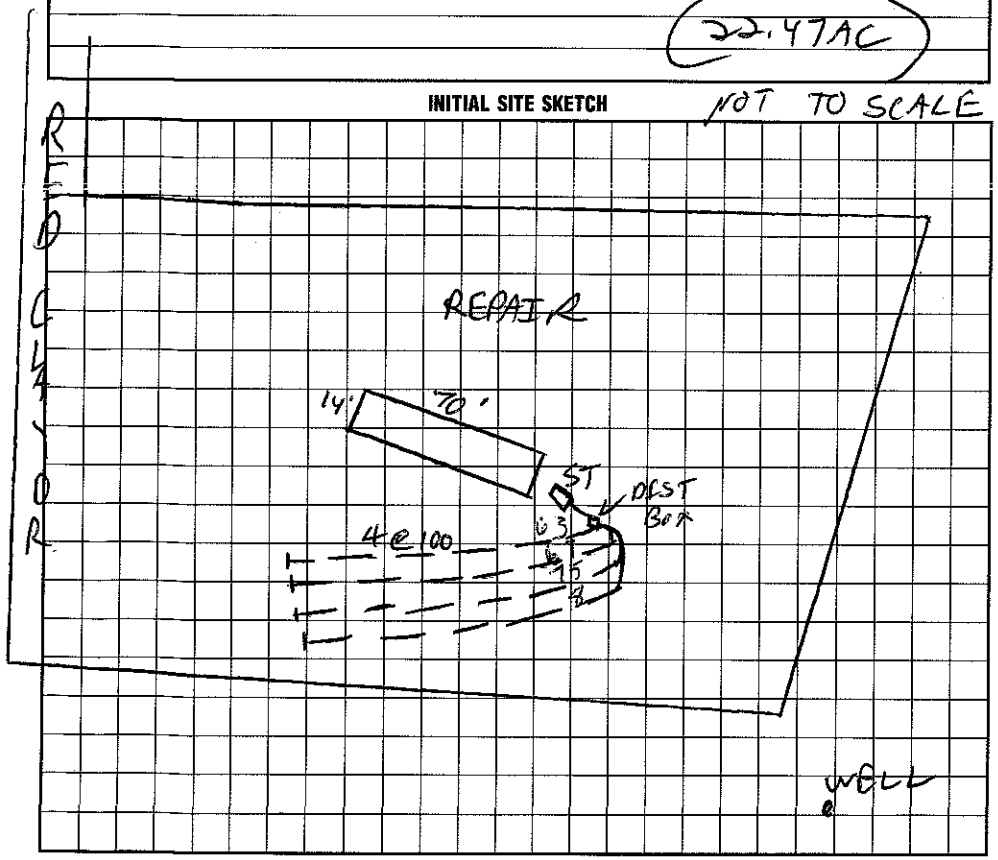

AS BUILT SKETCH

I understand that this permit can be suspended or revoked if any false information is supplied toward securing the permit/any unauthorized changes are made to the site/any unauthorized changes are made in the installation of the system. Improvement Permit with plat valid without expiration. Improvement Permit with site plan valid for sixty months. Authorization to Construct is valid for a period equal to that of Improvement Permit – not to exceed sixty months.

Signed: Fred Wright date

Improvement Permit by: C. Ferguson RS date 7/2/98

Authorization to Construct by: C. Ferguson RS date 7/2/98

Installed by: LARRY BEAM

Operation Permit by: C. Ferguson date 9/17/98

Existing System Inspection by: date

HEALTH DEPT. COPY: WHITE INSPECTION COPY (FINAL): GREEN OWNER COPY (FINAL): YELLOW INSPECTION COPY (INITIAL): PINK OWNER COPY (INITIAL): GOLD